


T.2S.R.1W.W.M.

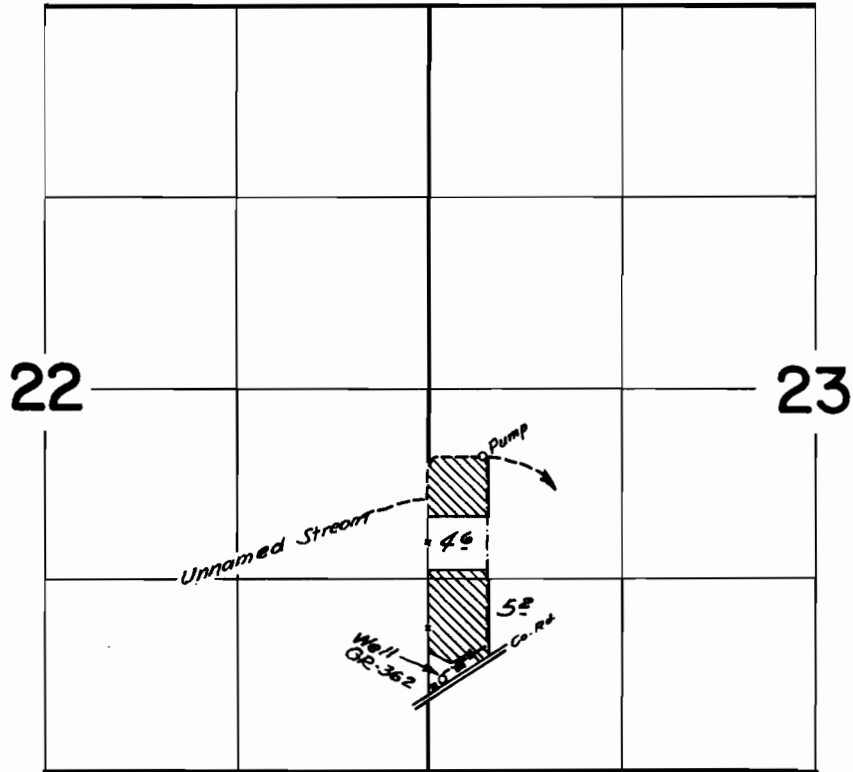

FINAL PROOF SURVEY
UNDER

Application No. 32060... Permit No. 25301....
IN NAME OF

FRED, FLOYCE & MARIANO SORIANO

Surveyed June 22 1961, by *R. Jackson*