


T.3S.R.1W.W.M.

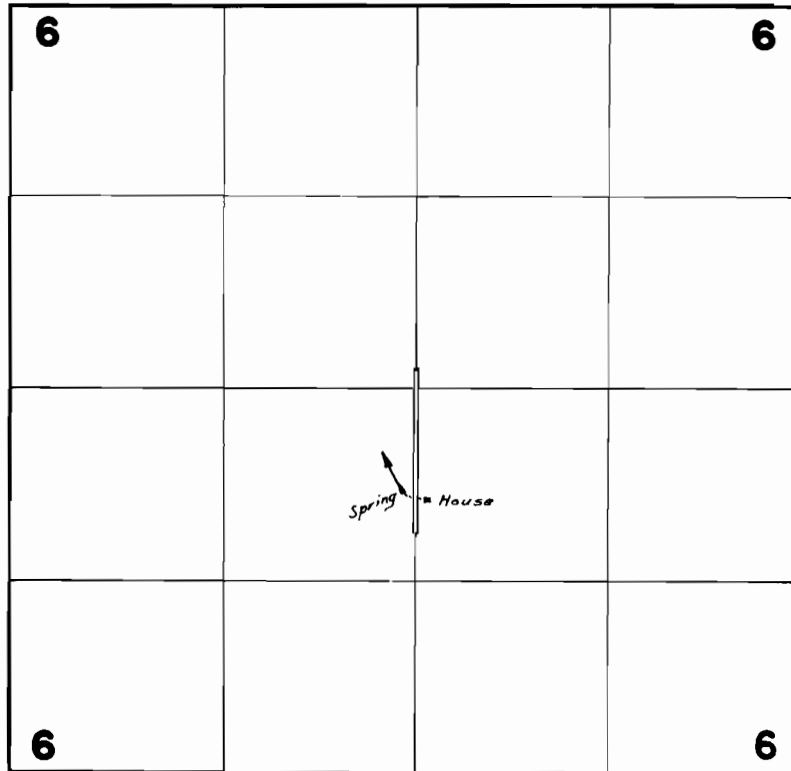

FINAL PROOF SURVEY  
UNDER

Application No. **32661** Permit No. **25992**  
IN NAME OF

**ROLLO R. OBERST**

Surveyed *August 17 1961*, by *R. Jackson*