


T. 5 S. R. 3 W. W. M.

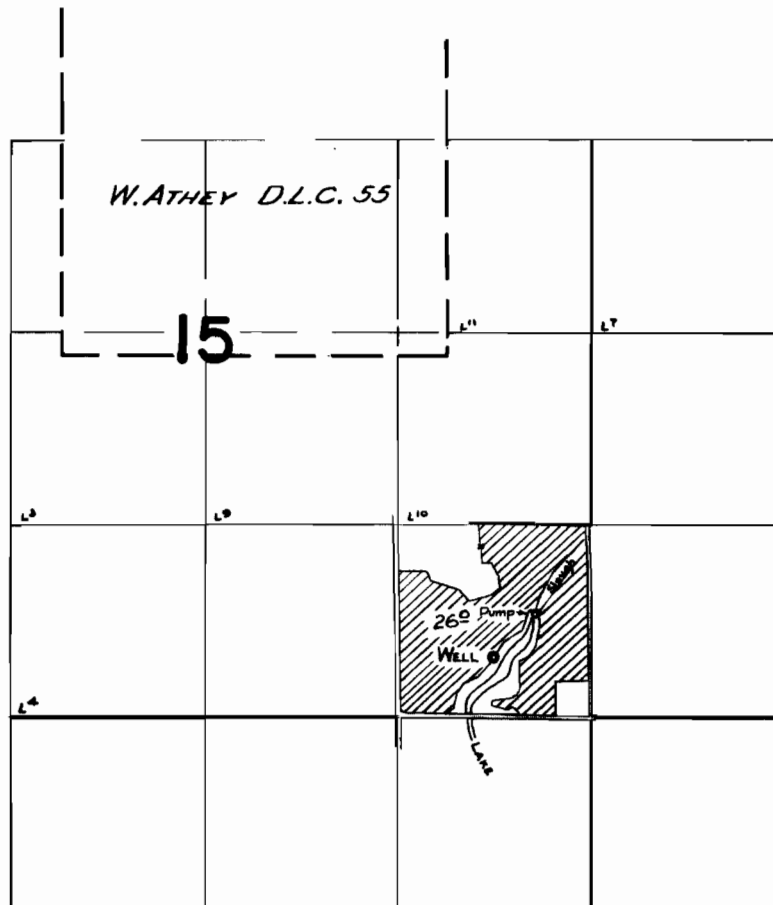

FINAL PROOF SURVEY
UNDER

Application No. G-854 Permit No. G-755
IN NAME OF

DONALD R. WILEY

Surveyed 27 APRIL 1961, by M. O. S. [Signature]