


# T. 5 S. R. 4 W. W. M.

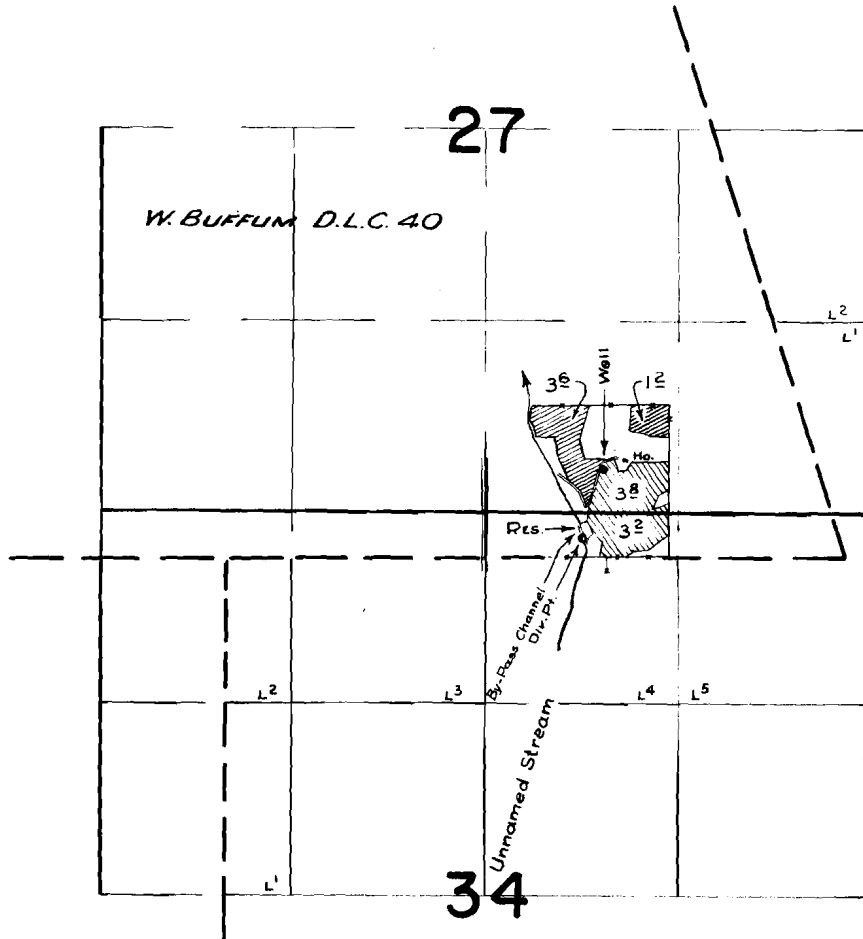

## FINAL PROOF SURVEY UNDER

24762                      20485  
Application No. R-25437    Permit No. R-1200  
IN NAME OF

*A. H. JORGENSEN*

Surveyed 24 APRIL 1961, by *M. B. Bick*