


T. 5 S. R. 4 W. W. M.

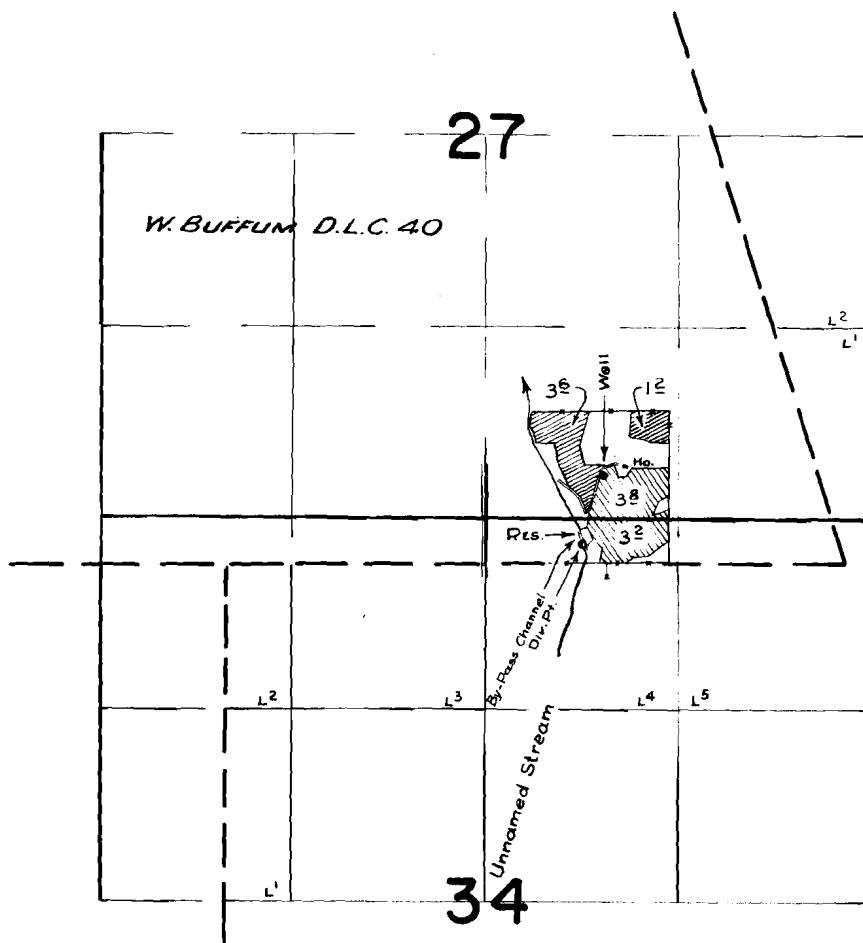

FINAL PROOF SURVEY UNDER

24762 20485
Application No. R-25437 Permit No. R-1200
IN NAME OF

A. H. JORGENSEN

Surveyed 24 APRIL 1961, by *M. B. Bick*