


# T. 3 S. R. 2 W. W. M.

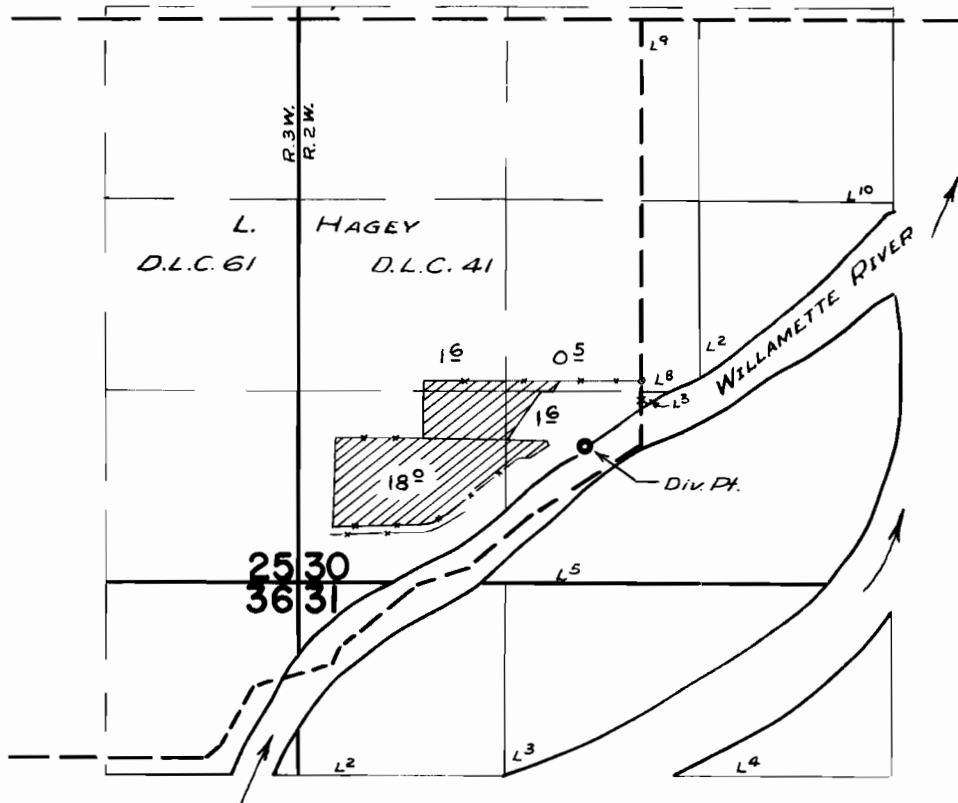

## FINAL PROOF SURVEY UNDER

Application No. 31640 Permit No. 25022  
IN NAME OF

*JOHN "JACK" SHELBURNE, JR.*

Surveyed 6 APRIL 1961, by *m. B. ...*