


T.5 S.R.5 W.W.M.

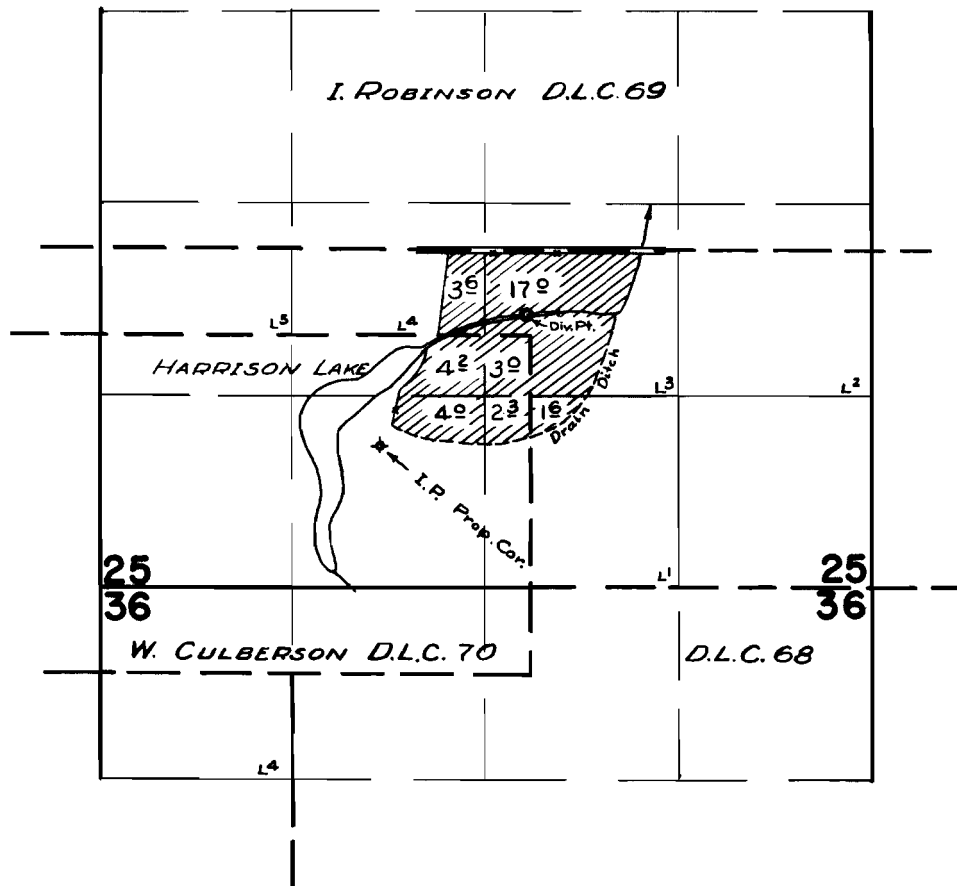

FINAL PROOF SURVEY UNDER

Application No. 32926 Permit No. 26021
IN NAME OF

NORVAL GOFFENA

Surveyed 25 APRIL 1961, by m. B. Seal