


T. 3 S. R. 2 W. W. M.

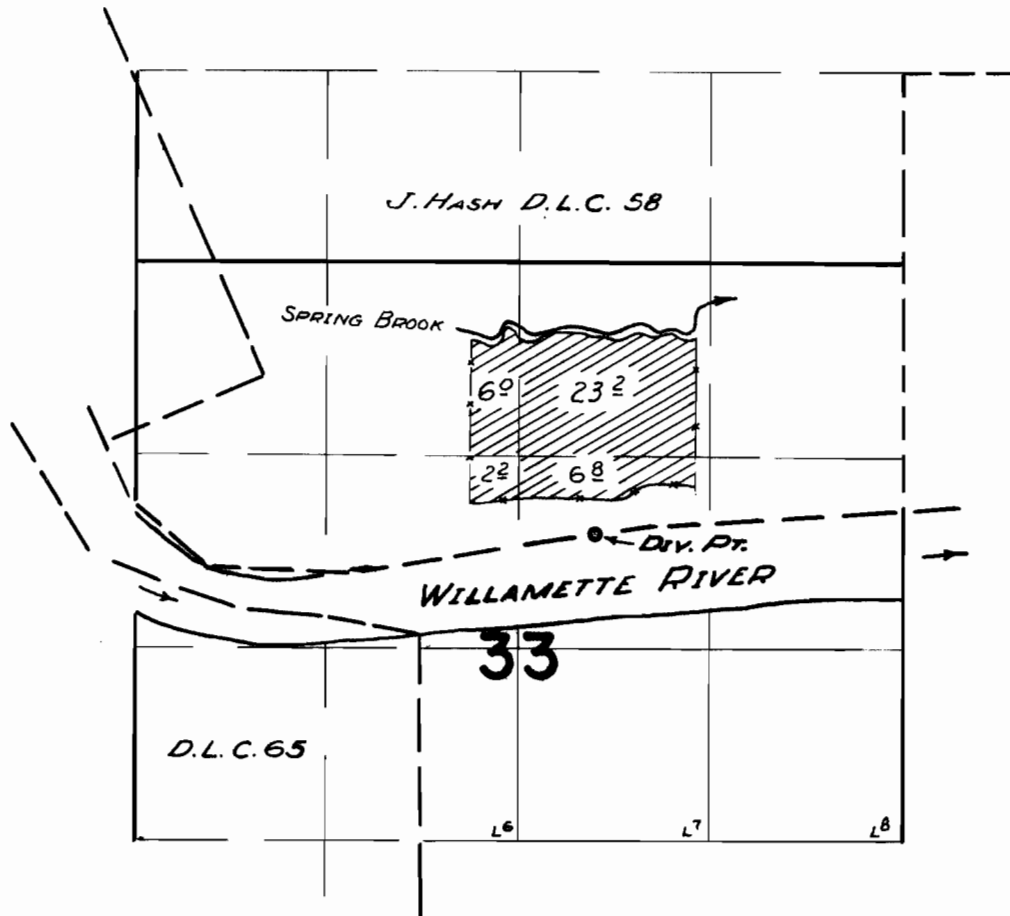

FINAL PROOF SURVEY
UNDER

Application No. 33932 Permit No. 26814
IN NAME OF

C. H. WHEELER

Surveyed 6 APRIL 1961, by J. M. Bish