


T.14S.R.5W.W.M.

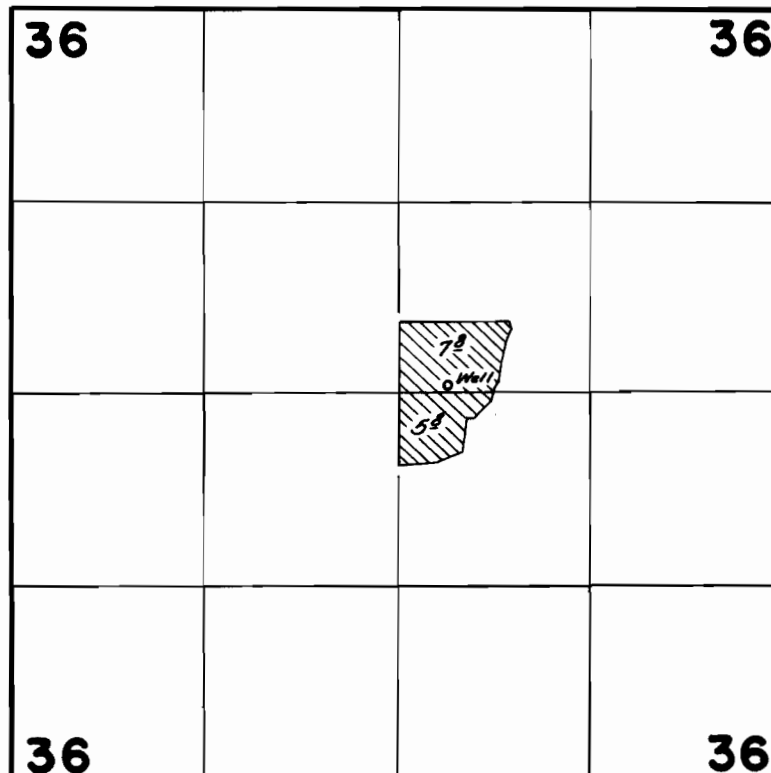

FINAL PROOF SURVEY
UNDER

Application No. G-1421 Permit No. G-1289
IN NAME OF

MRS. ANNIE WALDEN

Surveyed JUNE 12 1961, by C. B. Bault