


T.14 S. R. 8 W. W.M.

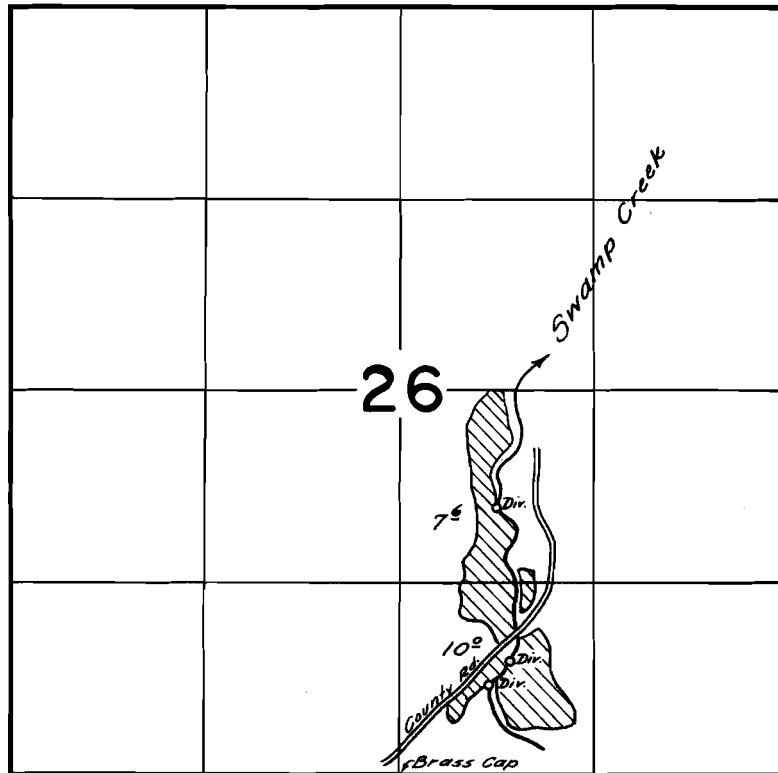

FINAL PROOF SURVEY
UNDER

Application No. 27615.... Permit No. 21753....
IN NAME OF

Harvey D. Anderson

Surveyed June 14 1961, by CD Bartels