


T.15S.R.8W.W.M.

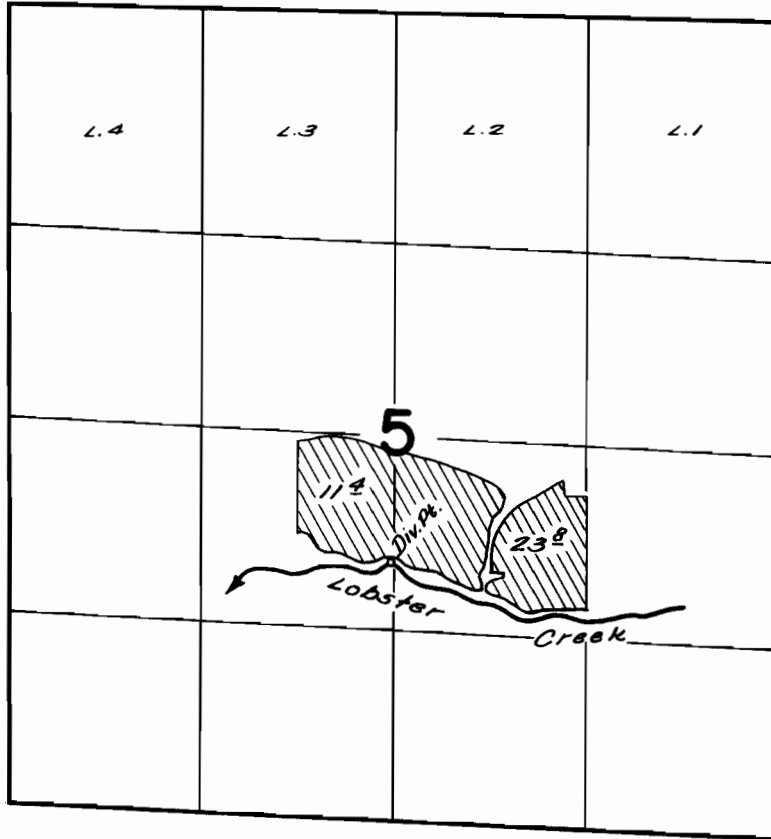

FINAL PROOF SURVEY
UNDER

Application No. *28025*... Permit No. *22427*...
IN NAME OF

.....*NORMAN SAPP*.....

Surveyed *June 14 1961*, by *C. Bastila*.....