


T.14S.R.6W.W.M.

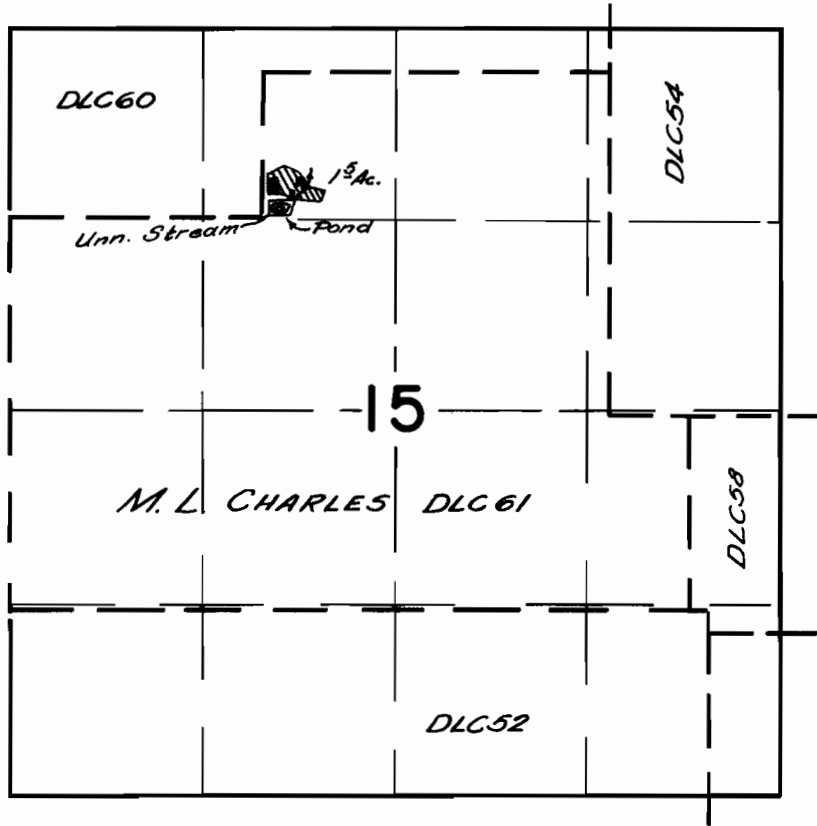

FINAL PROOF SURVEY UNDER

Application No. *R-31505* Permit No. *R-2011*
31506 *22854*
IN NAME OF

Ralph Malcom

Surveyed *June 15* 19*61*, by *C. B. Smith*