


# T.14S.R.6W.W.M.

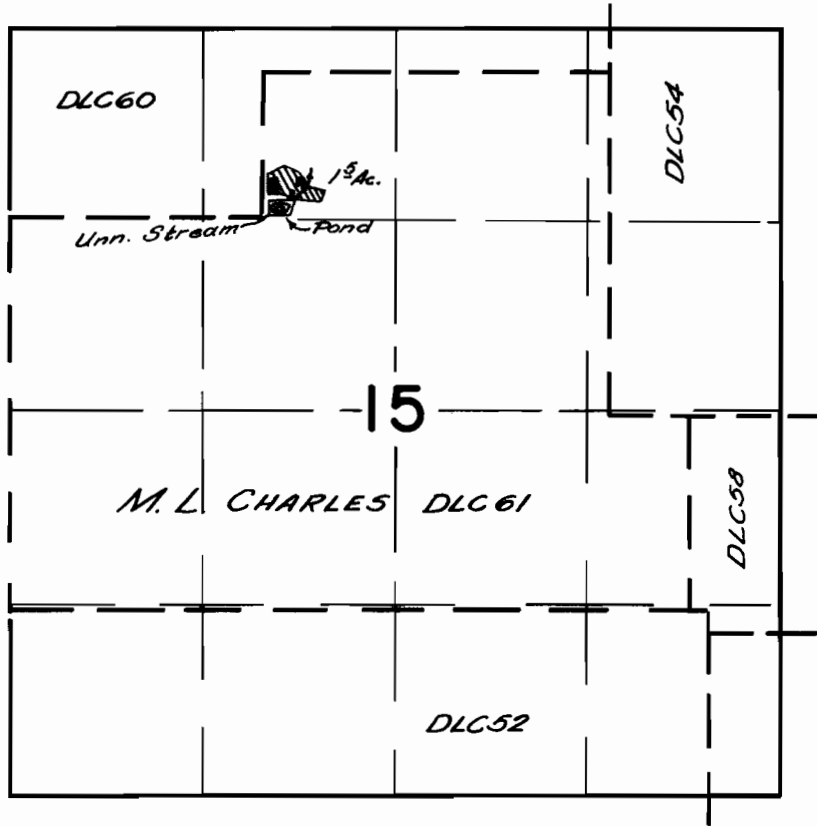

## FINAL PROOF SURVEY UNDER

Application No. *R-31505* Permit No. *R-2011*  
*31506* *22854*  
IN NAME OF

*Ralph Malcom*

Surveyed *June 15* 19*61*, by *C. B. Smith*