


T.14 S. R. 5 W. W.M.

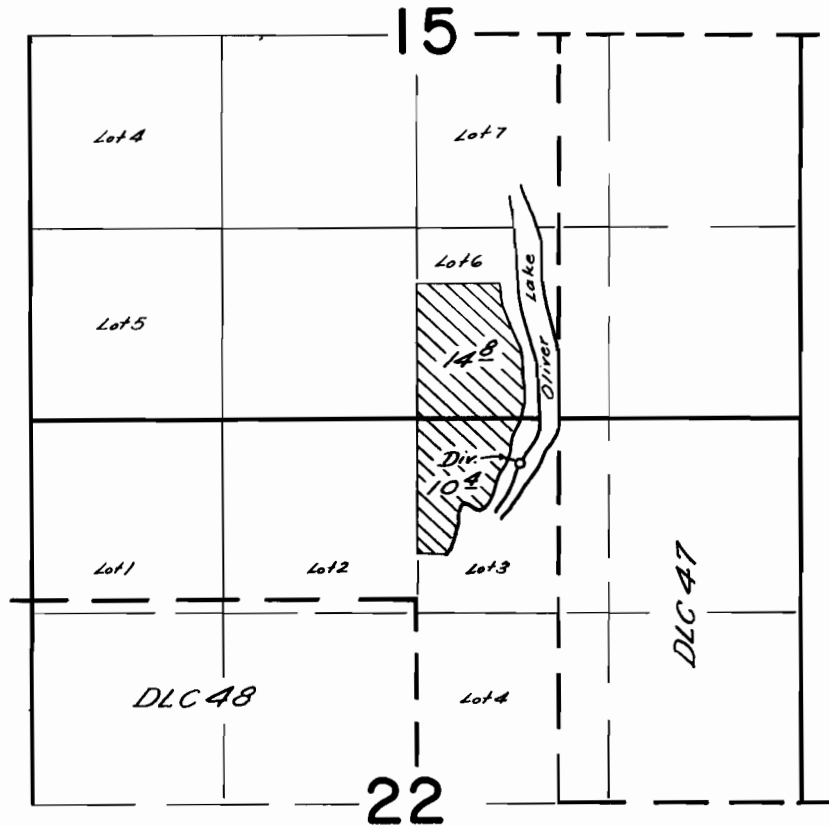

FINAL PROOF SURVEY  
UNDER

Application No. 32259 Permit No. 25448  
IN NAME OF

Anna M. Doolittle

Surveyed June 15 1961, by C. O. Bartels