


T.12S.R.5W.W.M.

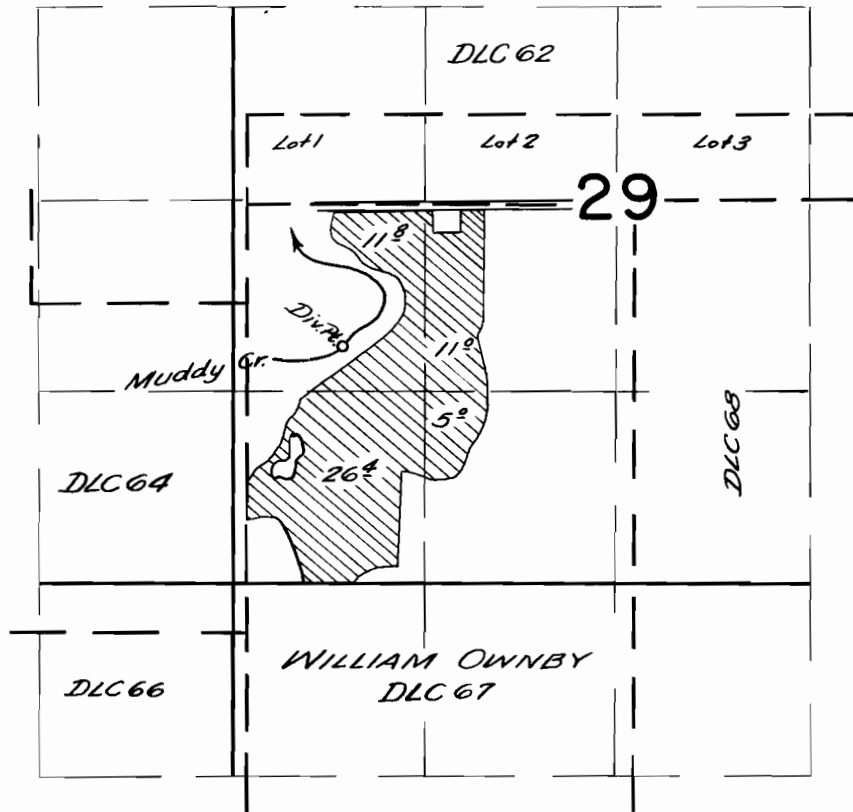

FINAL PROOF SURVEY
UNDER

Application No. 32333 Permit No. 25511
IN NAME OF

FRED W. & IRENE H. SMITH

Surveyed May 31 1961, by COBACI