


T.13S.R.5W.W.M.

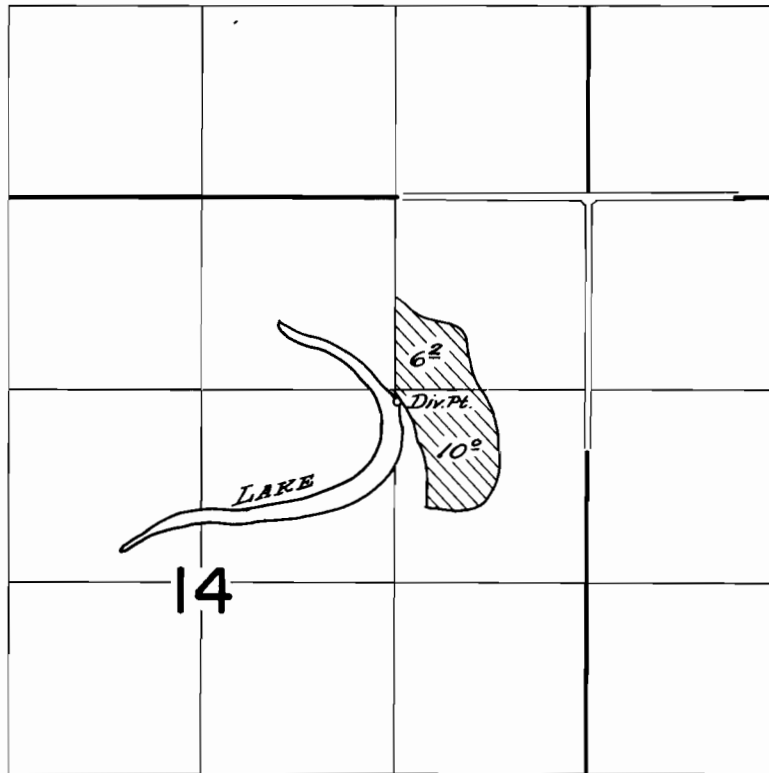

FINAL PROOF SURVEY
UNDER

Application No. 32367 Permit No. 25560
IN NAME OF

Homer & Andrea Mackey

Surveyed June 2, 1961, by C. Bartels