


T.35 S. R. 11 W. W. M.

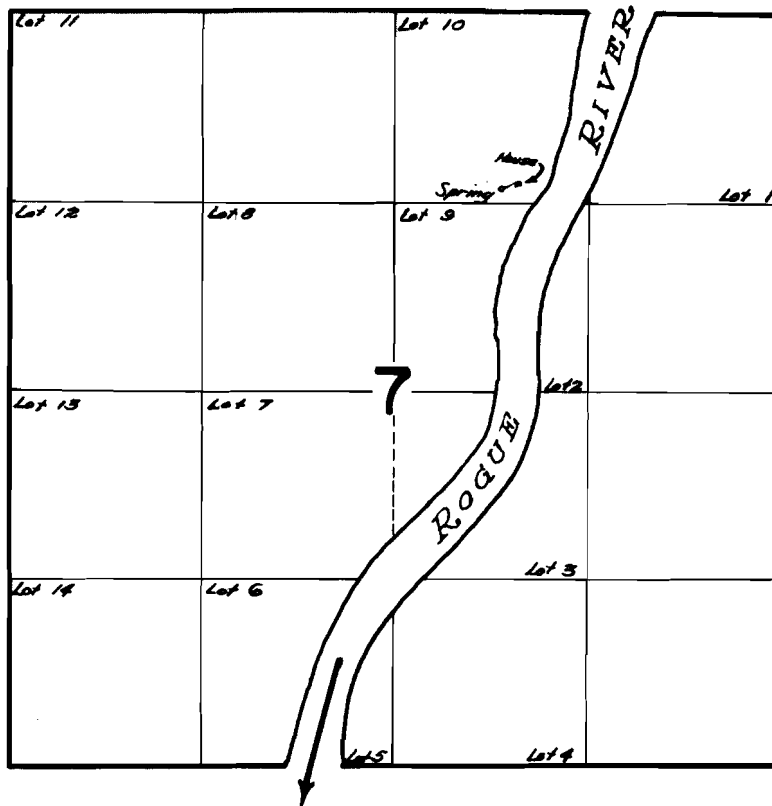

FINAL PROOF SURVEY UNDER

Application No. 30273... Permit No. 23846...
IN NAME OF

MRS. LYLE (ETHEL) McCULLOCH

Surveyed August 29 1961, by G. O. Bartels.