


T.36S.R.14W.W.M.

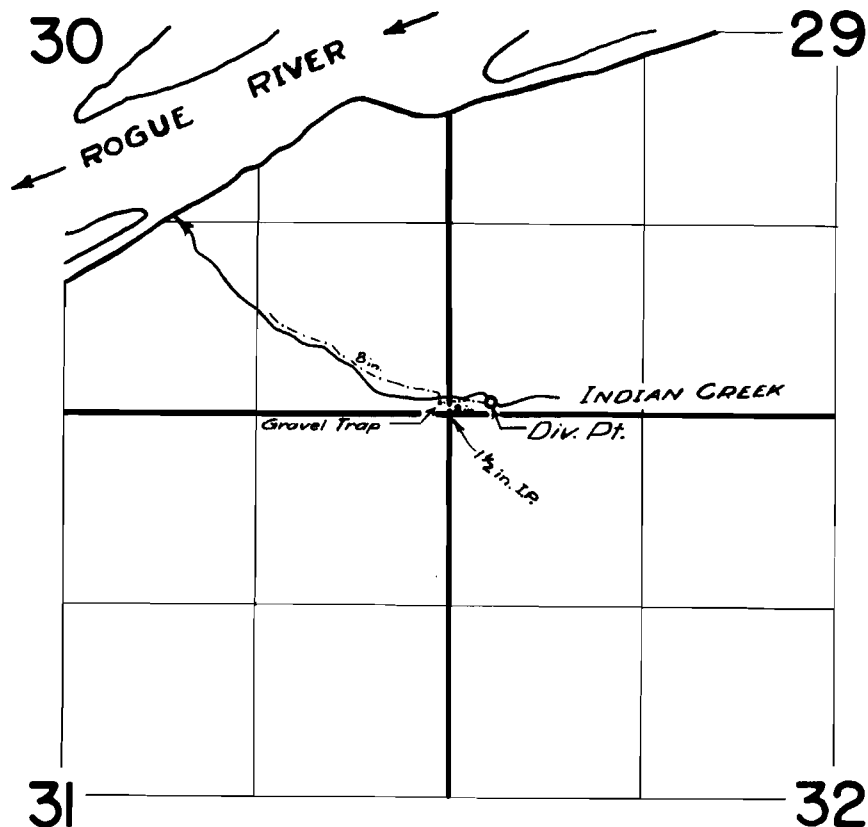

FINAL PROOF SURVEY
UNDER

Application No. 30427 Permit No. 23899
IN NAME OF

CITY OF GOLD BEACH

Surveyed 7 Aug. 1961, by M. Bish