


T.32 S.R.15 W.W.M.

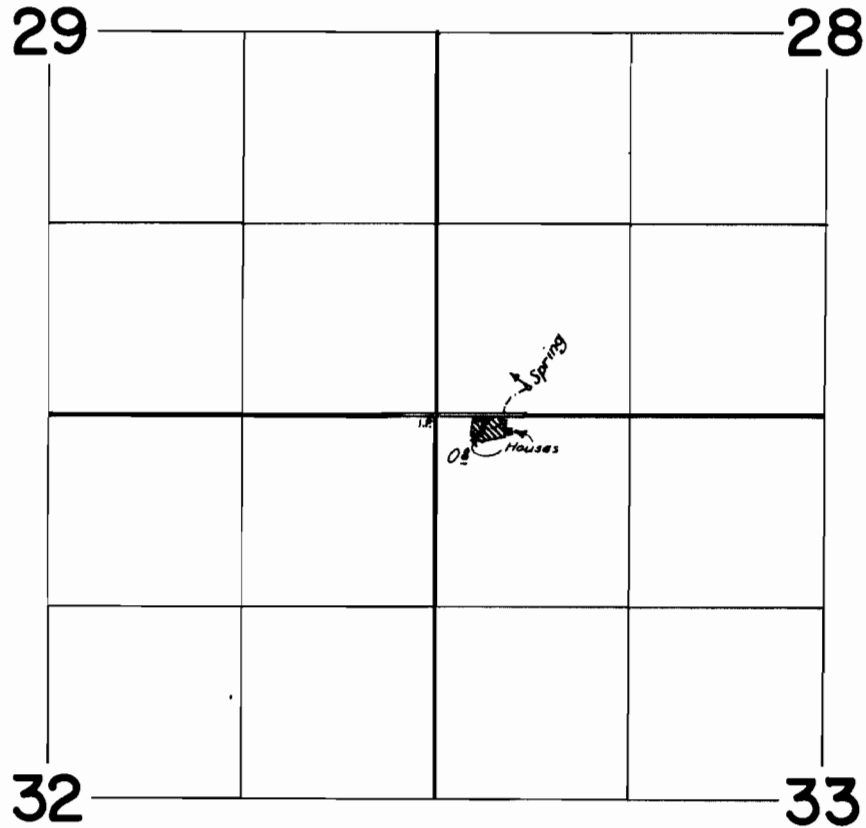

FINAL PROOF SURVEY
UNDER

Application No. 30470... Permit No. 24000...
IN NAME OF

MOSS AVERILL

Surveyed *August 3, 1961*, by *[Signature]*