


T.31S.R.15W.W.M.

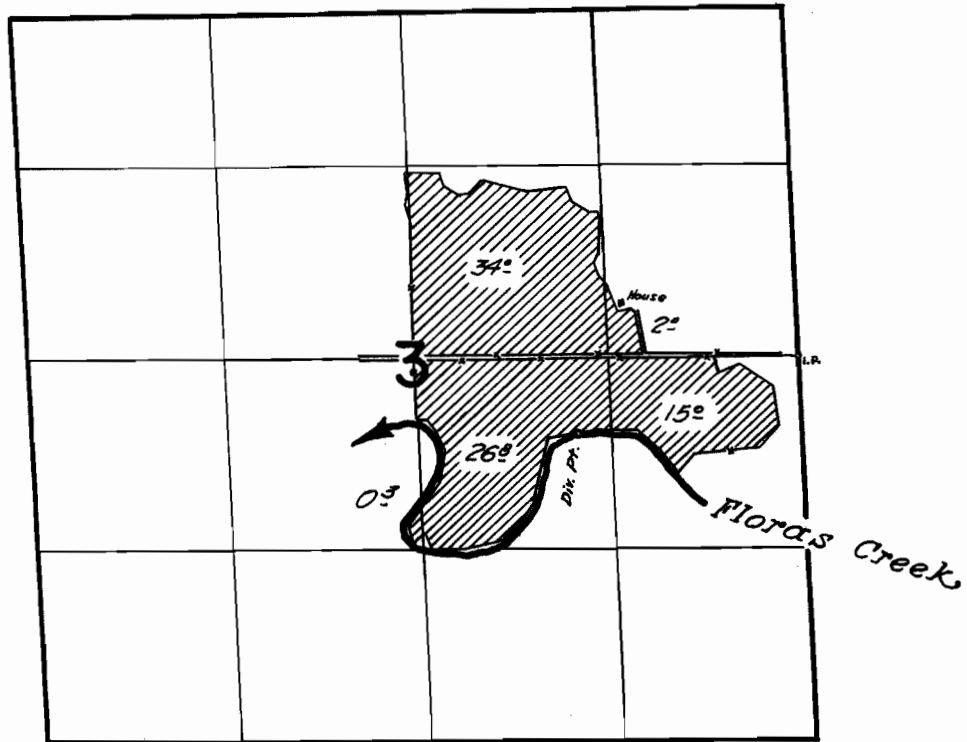

FINAL PROOF SURVEY
UNDER

Application No. 31856..... Permit No. 25115.....
IN NAME OF

RAYBURN T. & DOROTHY J. GUERIN

Surveyed August 3 1961., by R. Jackson