


T.36S.R.14W.W.M.

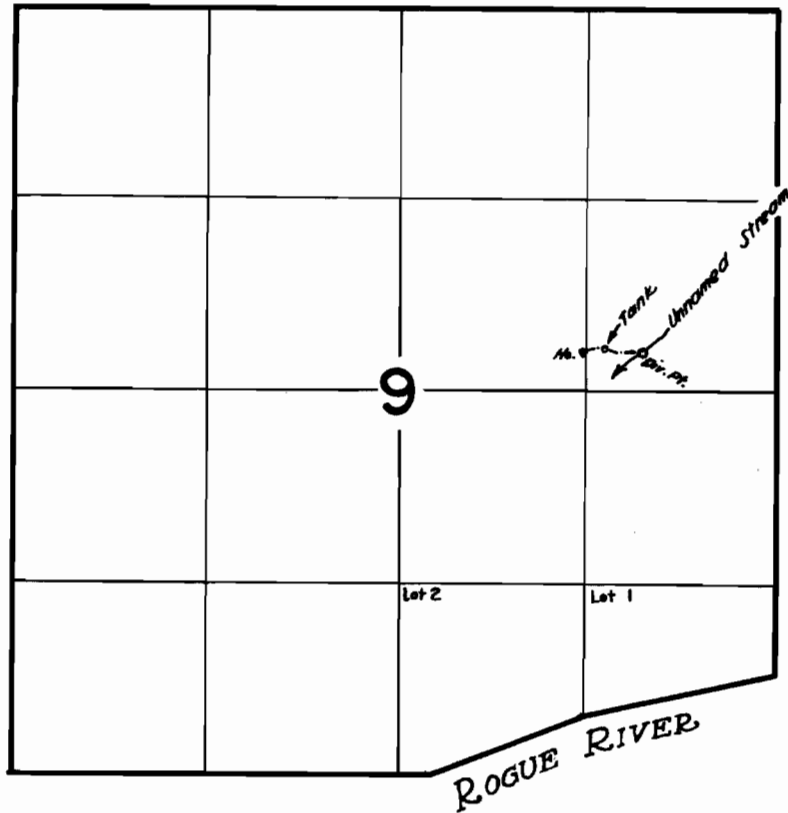

FINAL PROOF SURVEY
UNDER

Application No. 33914..... Permit No. 26719.....
IN NAME OF

.....SAMUEL ATHERTON.....

Surveyed August 7 1901., by R. Jackson