


T.31 S.R.5W.W.M.

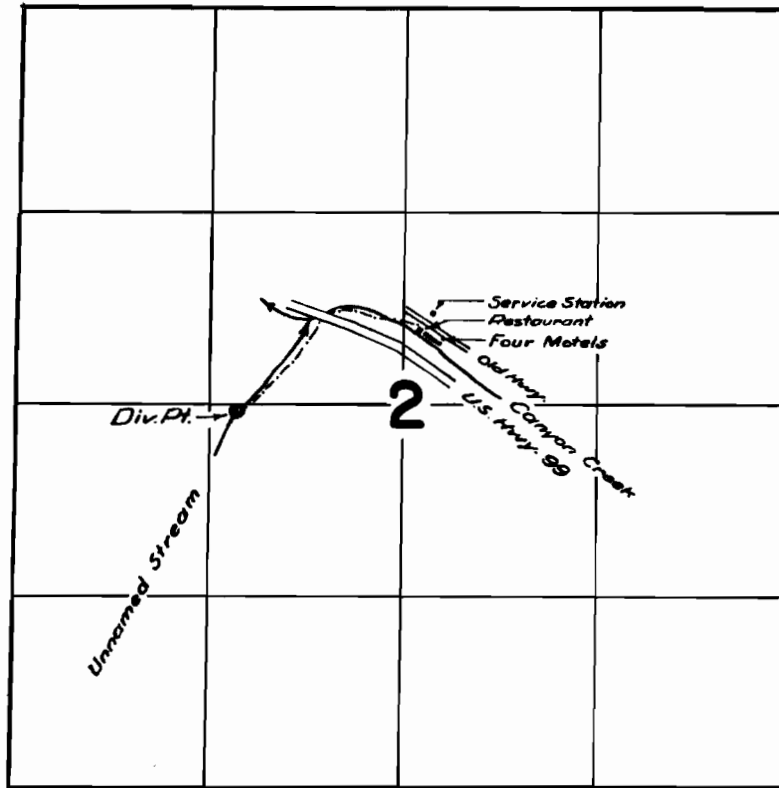

FINAL PROOF SURVEY UNDER

Application No. 28785 Permit No. 23956
IN NAME OF

K.P. HUSSEY

Surveyed 14 June 1961, by M. B. [Signature]