


# T.30S.R.5W.W.M.

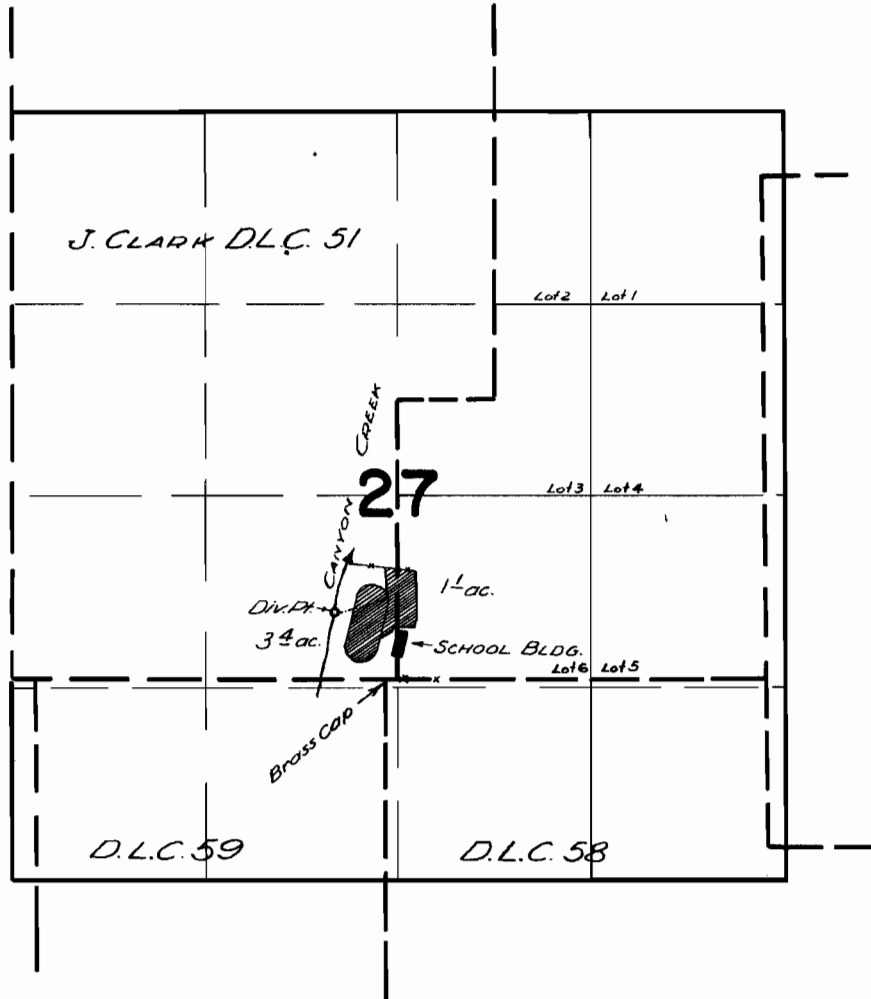

## FINAL PROOF SURVEY UNDER

Application No. 31798 Permit No. 25092  
IN NAME OF

SCHOOL DIST. No. 8, DOUGLAS COUNTY

Surveyed 14 JUNE 1961, by M. B. Bish