


T. 32 S. R. 5 W. W.M.

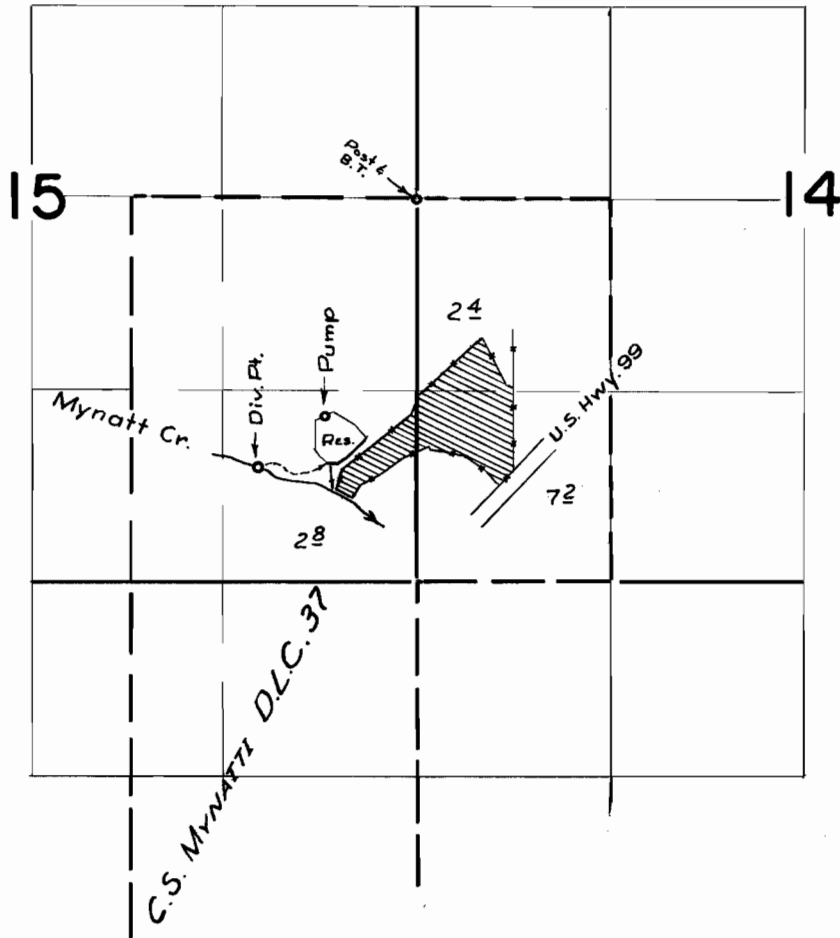

FINAL PROOF SURVEY
UNDER

Application No. R-33003 33004 Permit No. R-2237 26121
IN NAME OF

LOUIS BRADY

Surveyed 4 MAY 1961, by M. Bish