


T.29S. R.6W.W.M.

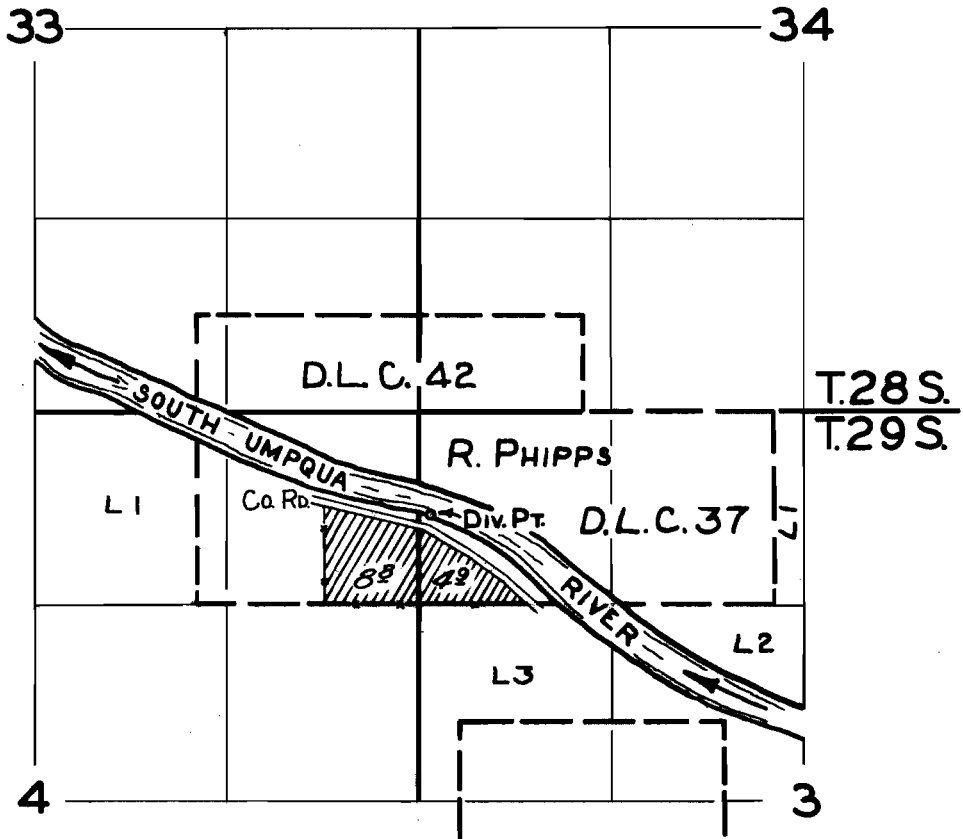

FINAL PROOF SURVEY
UNDER

Application No. ~~33833~~ Permit No. 26675...
IN NAME OF

.....ALTON E. & LELA S. RICE.....

Surveyed May 3... 1961., by C.D. BARTELS.