
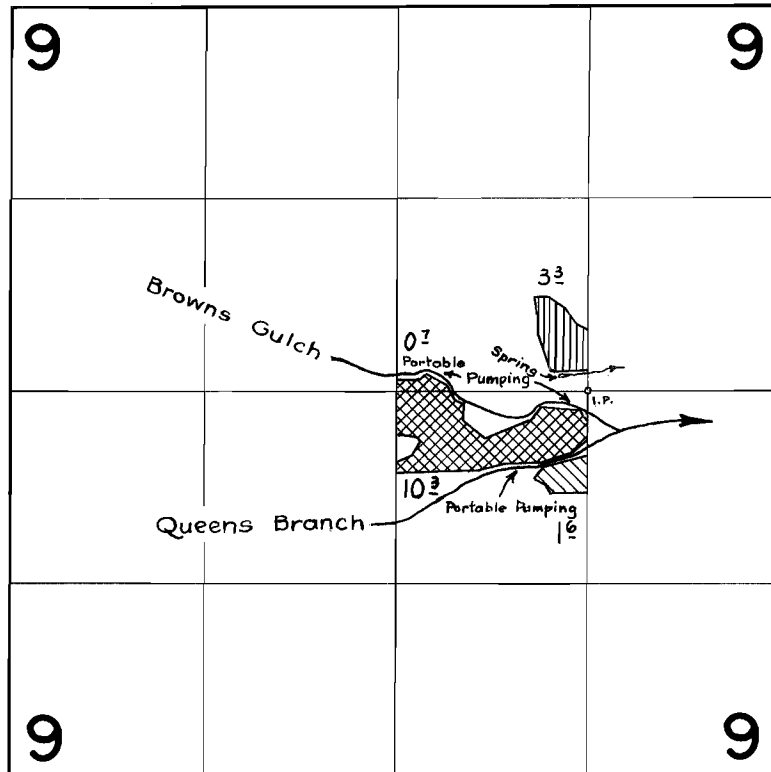


T.35S.R.4W.W.M.

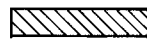

-  Irrigated from Spring
-  Irrigated from Queens Branch
-  Irrigated from Browns Gulch

FINAL PROOF SURVEY
UNDER

Application No. **25904** Permit No. **20323**
IN NAME OF

NEIL MOORE

Surveyed April 17 1961, by

[Signature]