


T. 33 S., R. 2 E., W. M.

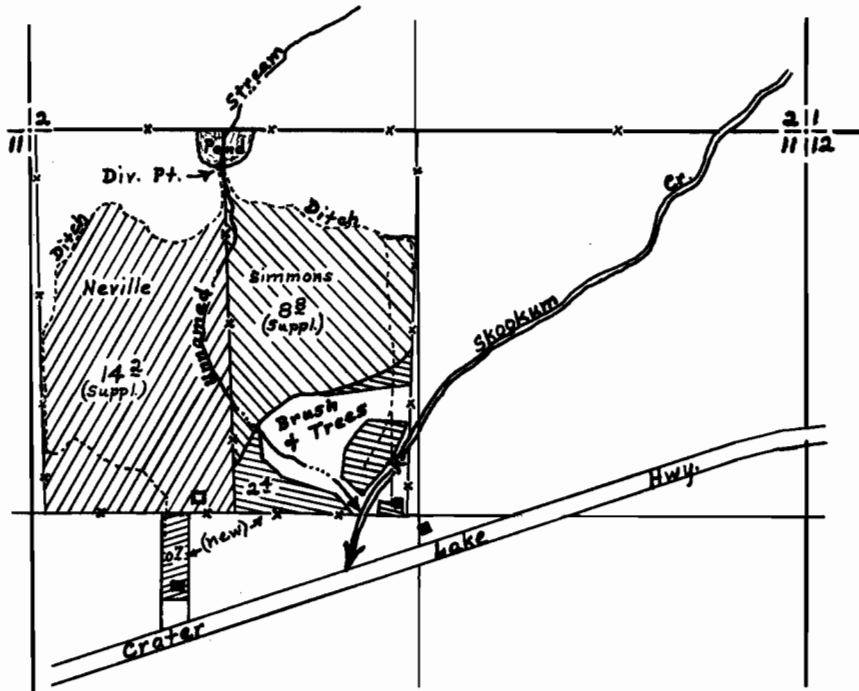

RECEIVED
JAN 24 1962
STATE ENGINEER

FINAL PROOF SURVEY
UNDER

Application No. 30816 Permit No. 24259
IN NAME OF

F. W. Simmons & David Neville

Surveyed Nov. 14, 1961, by D. B. Hendrix

Scale: 8" = 1 mile