


T. 35 S., R. 2 W., W.M.

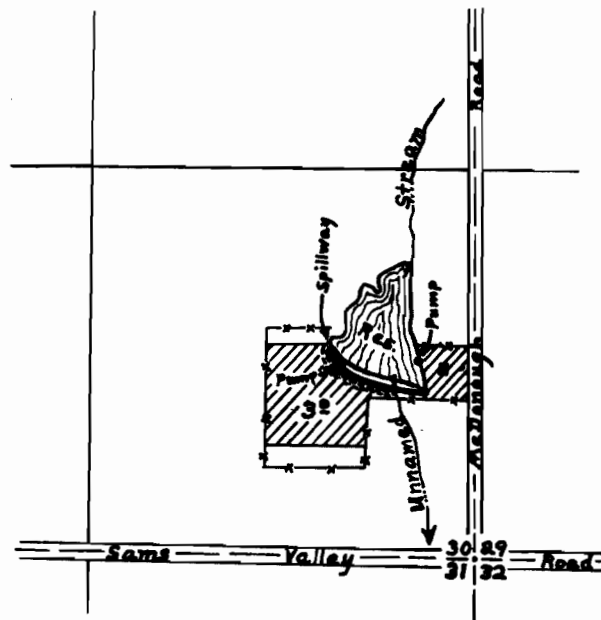

(Scale: 8" = 1 mile)

FINAL PROOF SURVEY UNDER

Application No. R-31868 Permit No. R-2072
31869 25121
IN NAME OF

Ralph A. James

Surveyed March 20, 1962, by D. L. Hendrix