


T. 33 S., R. 1 W., W.M.

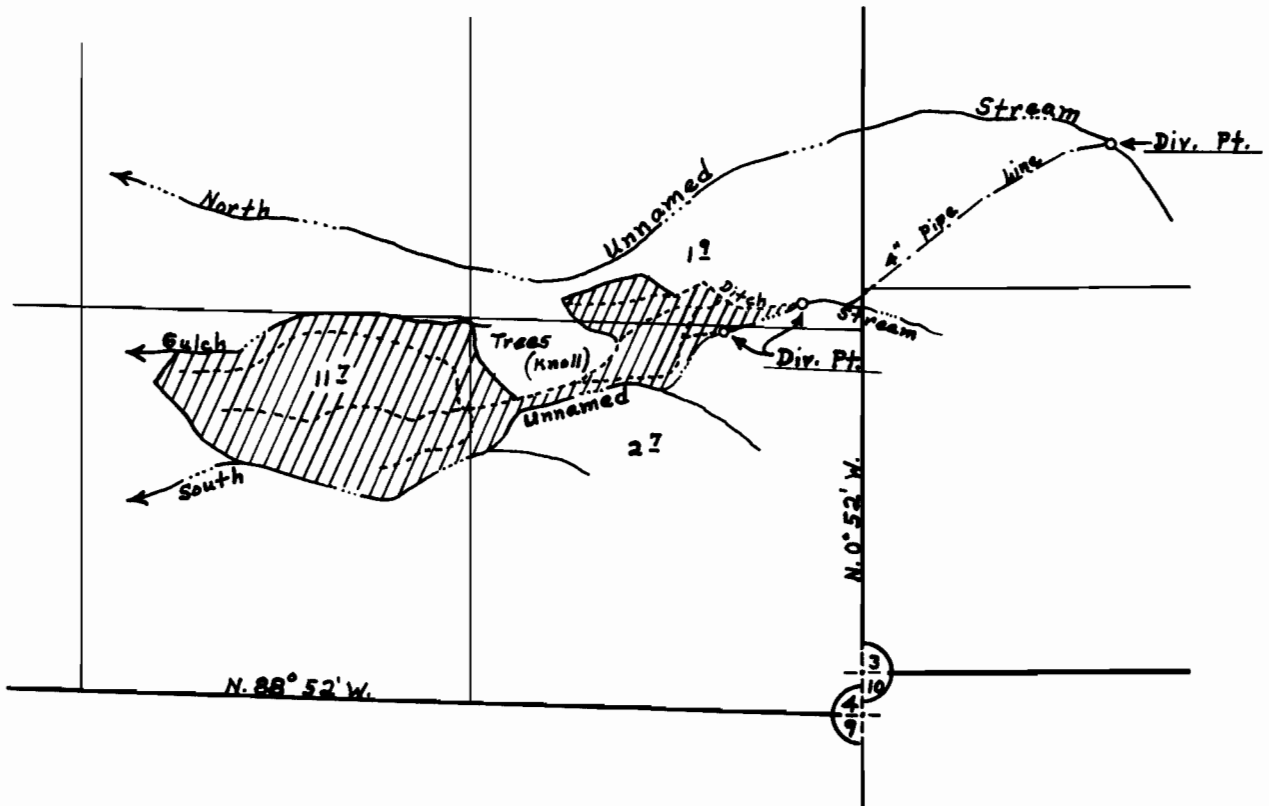

FINAL PROOF SURVEY
UNDER

Application No. 32655. Permit No. 25752
IN NAME OF

Chester R. Longbrake

Surveyed March 28, 1962, by *D. L. Hendrix*

Scale: 8" = 1 mile