


T. 33 & 34 S. R. 7 W. W.M.

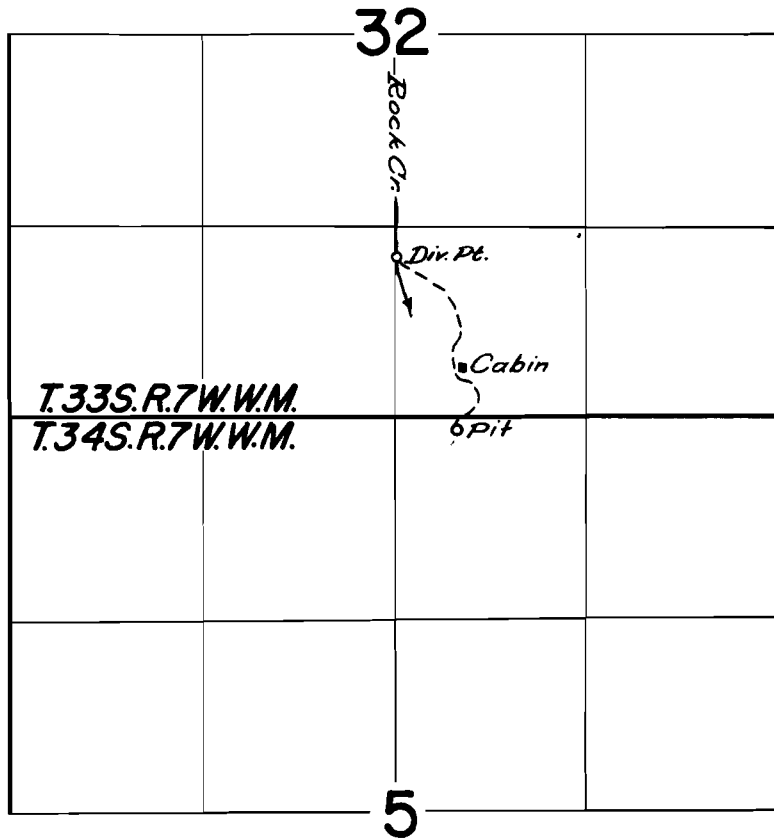

FINAL PROOF SURVEY
UNDER

Application No. 19384 Permit No. 14993
IN NAME OF

Edward S. Williams

Surveyed Oct. 5 1960, by R. Steimer