


TWP 38 S R 7 WWM

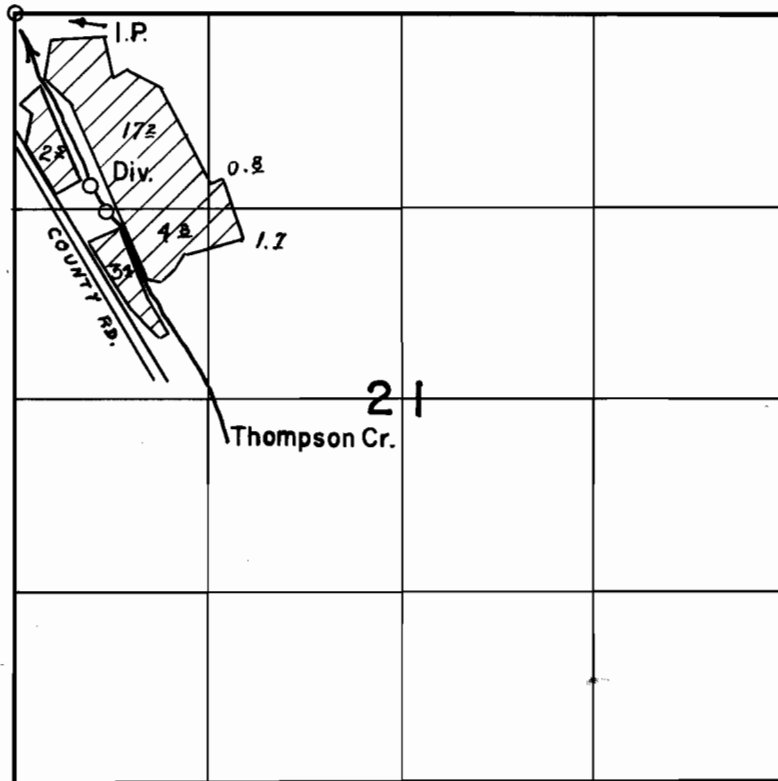

FINAL PROOF SURVEY
UNDER

Application No. 29273 Permit No. 23079
IN NAME OF

Homer L Goyette

Surveyed 3-8 1962, by RBSteimer