


39-8-16+17

TWP 39 S R 8 W W M

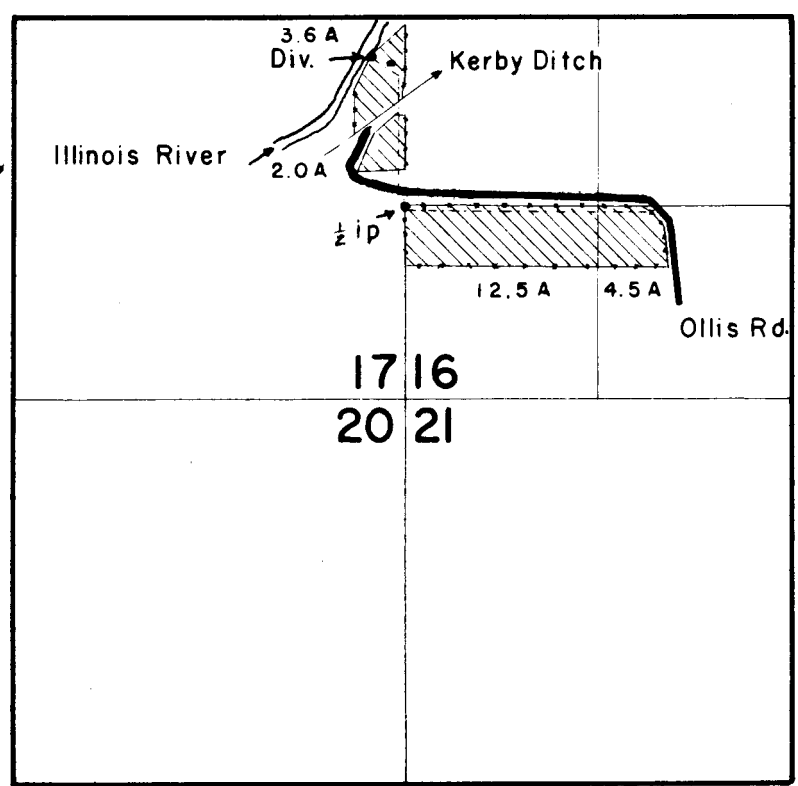

**FINAL PROOF SURVEY**  
**under**

Application No. 33530 Permit No. 26610  
in name of

JOE M & F IRENE OLLIS

Surveyed Sept. 28 1961 By Steimer