

Monument

Well #2

N. 0° 42' W. - 1287 1/2'

39 1/2'

40 1/2'

26 1/2'

Well #1

Lost River wells

Sunnyside

Irrigation

Appl. G-837
Per. G-759

County

Road

T. 41 S., R. 10 E., W.M.


6-759

I, William L. ²⁰¹²Wates, of
hereby certify that this
notes taken during a
me and completed
the monument shown
of a 5/8" steel reinfor
into the ground 24"
between Sections 8

fl
Regis

Oregon No. 1347.-Date

Just
River
wells

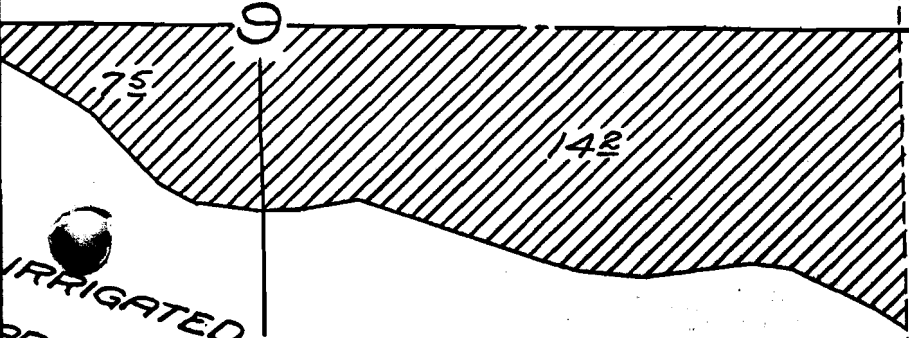

IRRIGATED
APPLICATION #U-379
PERMIT #U-354

District

Carol

N. 22.48. N. 1. - 2606 2/3

William L. Wates

LANDS
WEN
KLAMATH