


G-1564  
29725

# T.41S.R.10E.W.M.

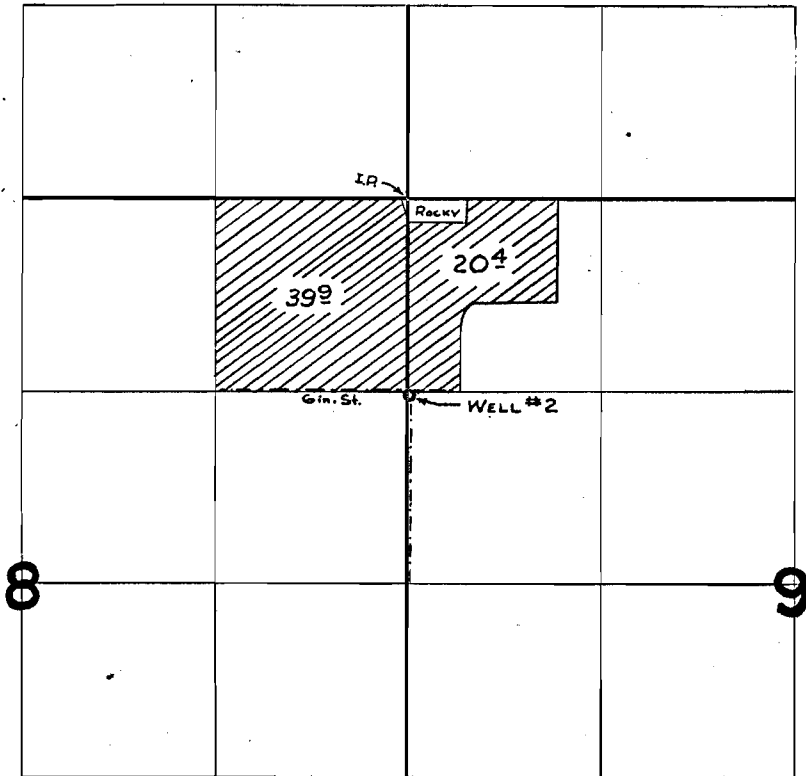

Just Pine Wells

## FINAL PROOF SURVEY UNDER

Application No. G-1704 Permit No. G-1564  
IN NAME OF

WENDELL MOORE

Surveyed 19 APRIL 1961, by M. A. Bish