


East River Mac.

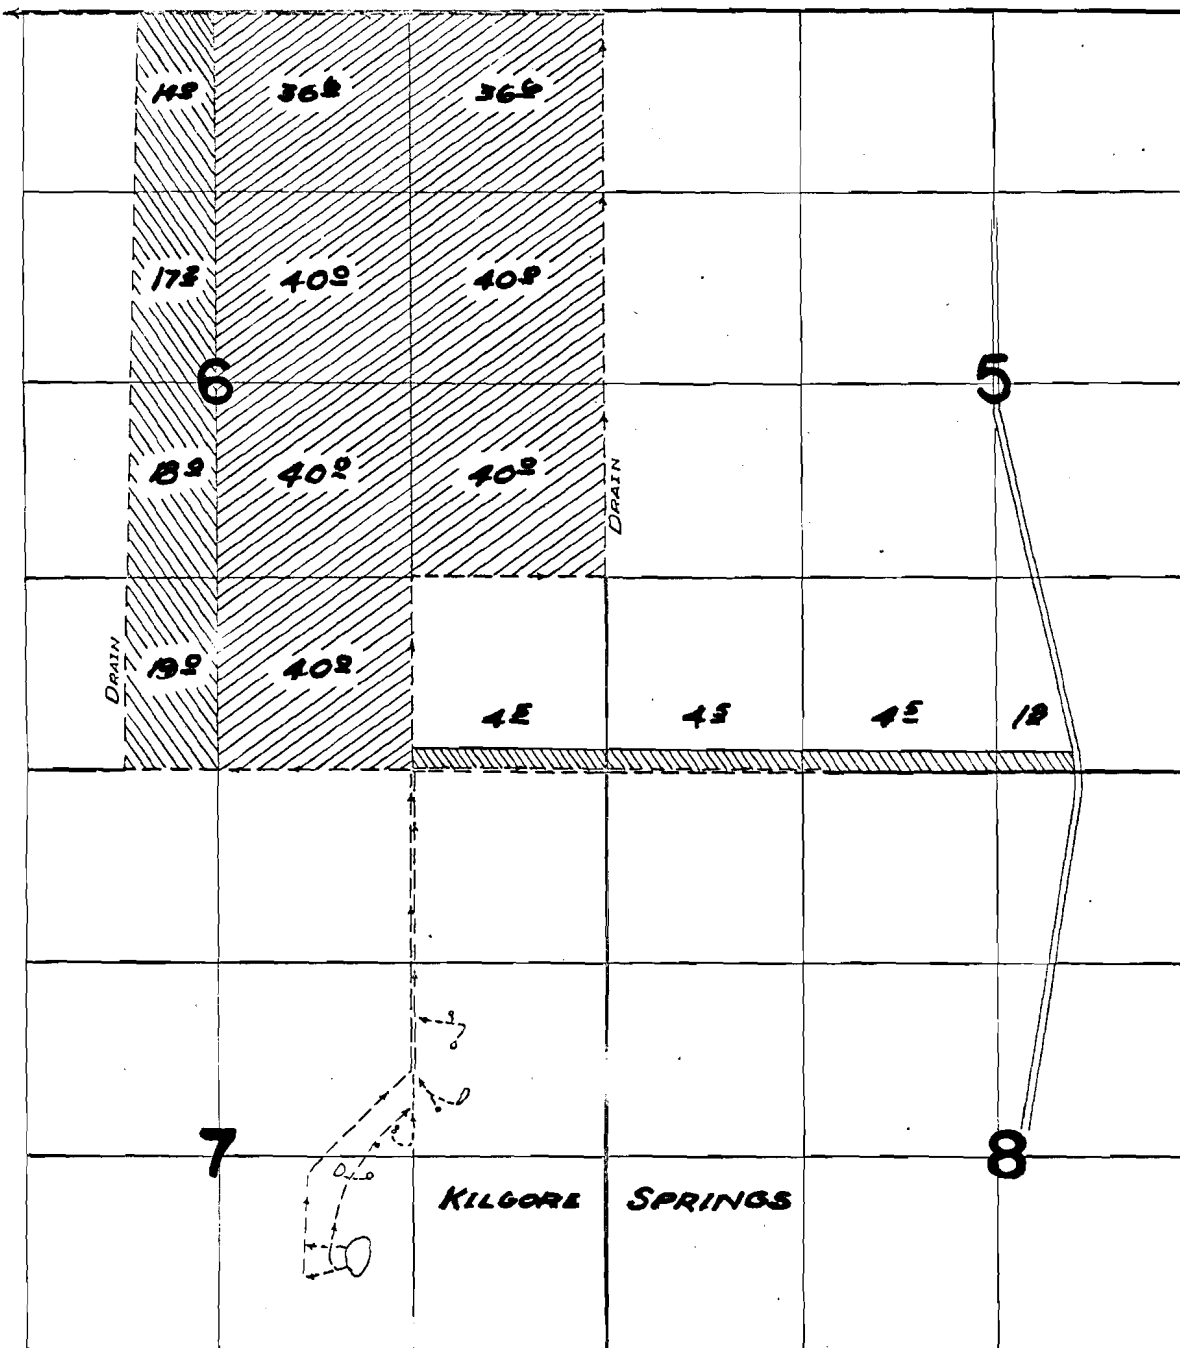

FINAL PLAN OF SURVEY

UNDER

Application No. 27549 21699
27677 Permit No. 21792

IN NAME OF

JOHNSON STOCK COMPANY

748 Oct. 60
Surveyed 12 APRIL 19 61, by *m. Bish*