


East River Mac.

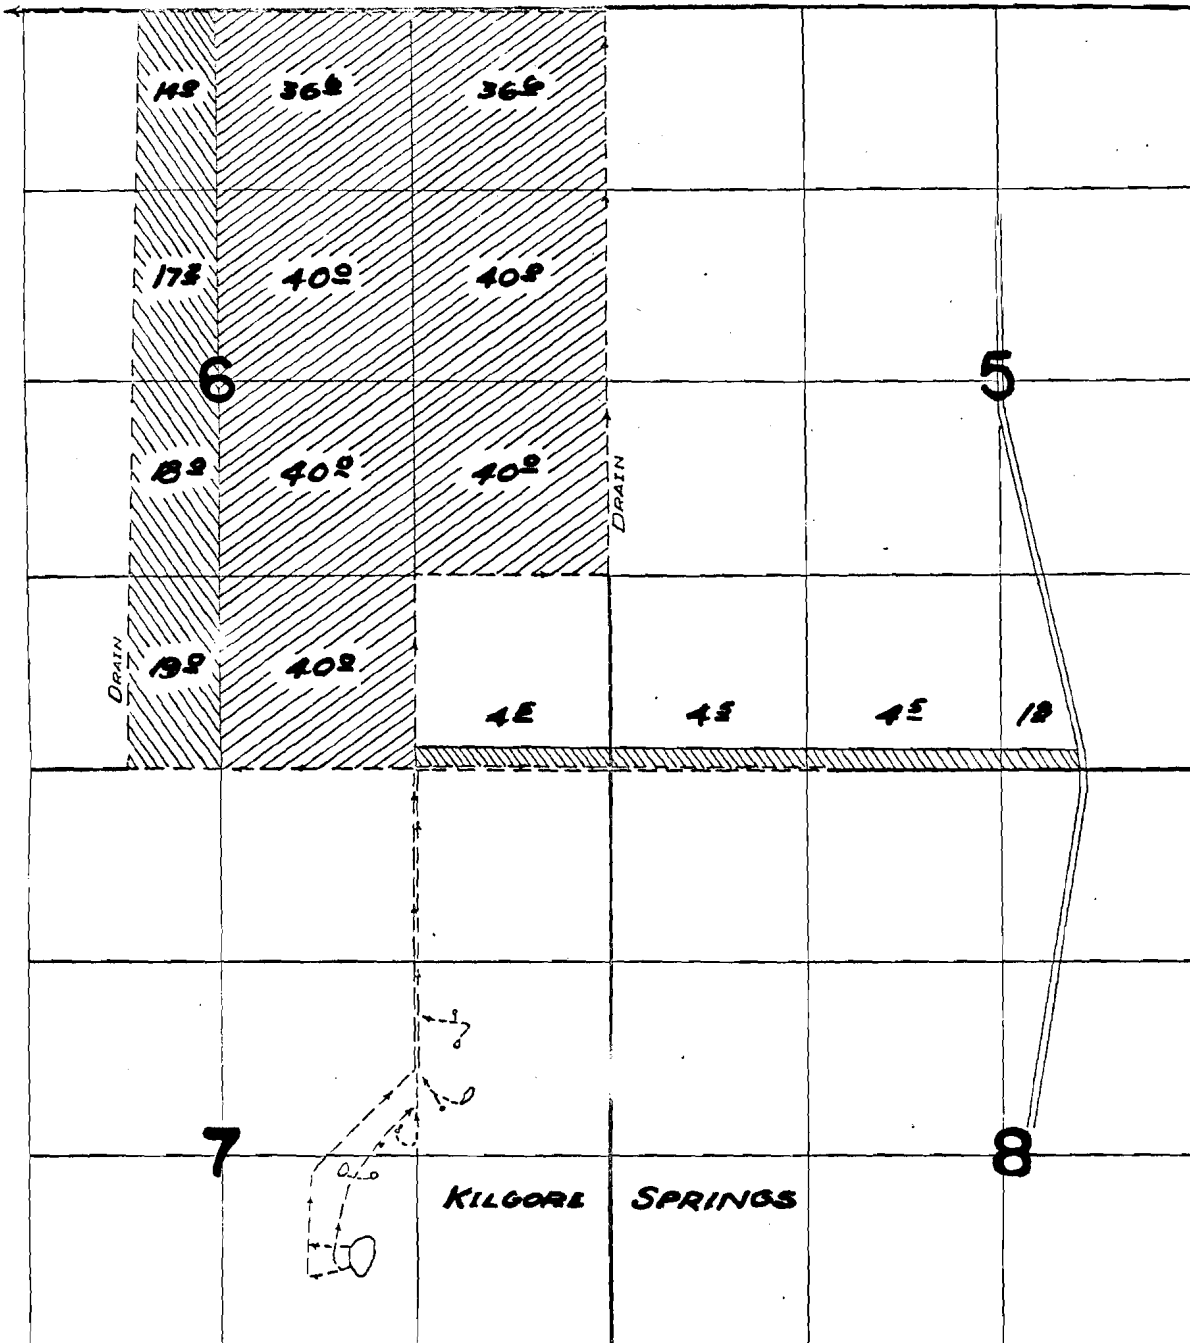

INITIAL PLAN OF SURVEY

UNDER  
 Application No. 27549 21699  
 Application No. 27677 Permit No. 21792

IN NAME OF  
**JOHNSON STOCK COMPANY**

748 Oct. 60  
 Surveyed 12 APRIL 61, by *M. B. Bish*