


# T. 36 S. R. 11 E. W. M.

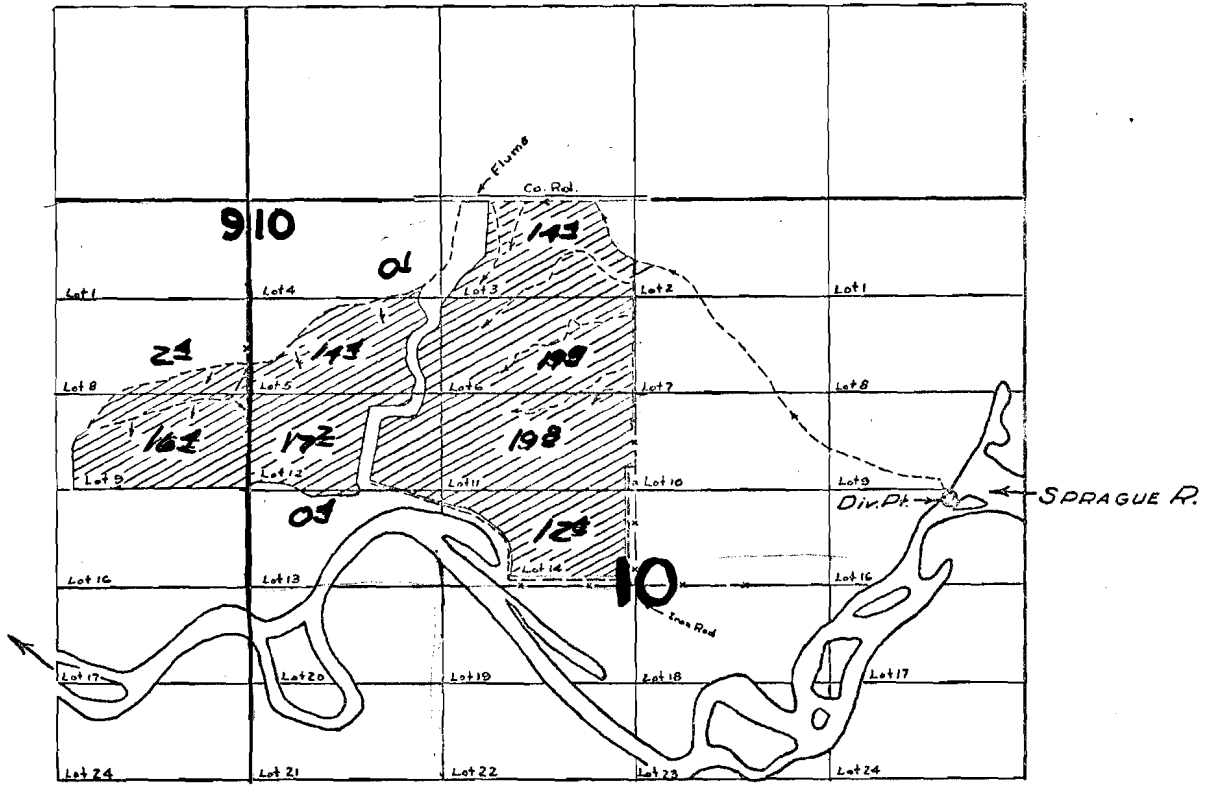

Sprague River

## FINAL PROOF SURVEY UNDER

Application No. 32046 Permit No. 25290  
IN NAME OF

OLIVER C. KINNEY

Surveyed 15 JULY 1961, by M. Bish