


# T. 36 S. R. 12 E. W.M.

Whiskey Ck. & M&E

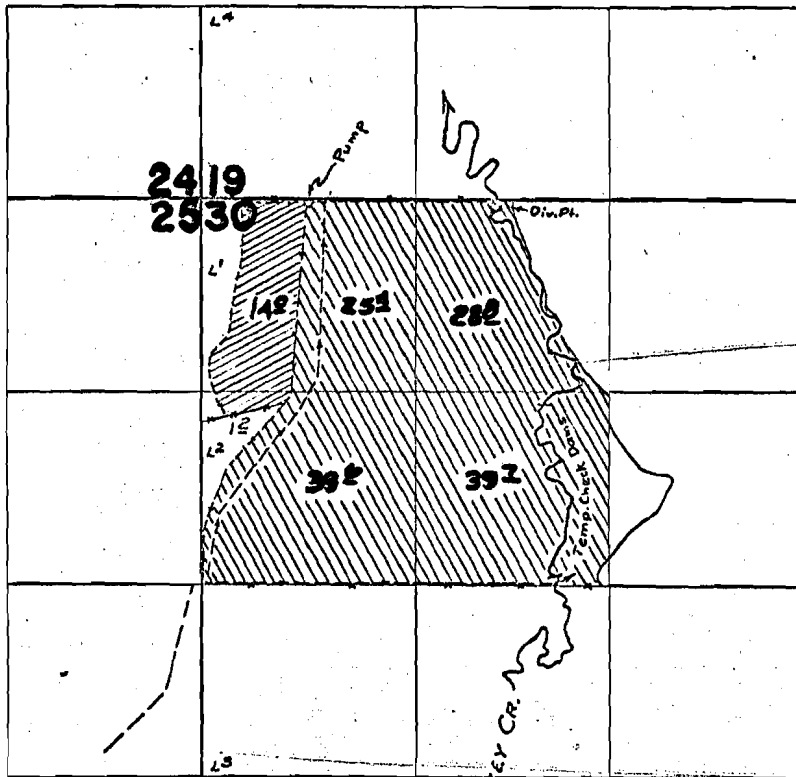

## FINAL PROOF SURVEY UNDER

Primary   
 Supplemental 

Application No. 33110 Permit No. 26173  
 IN NAME OF

WILFRED FIRSICK

Surveyed 15 JULY 1961, by M. Bish