


T.21S.R.3W.W.M.

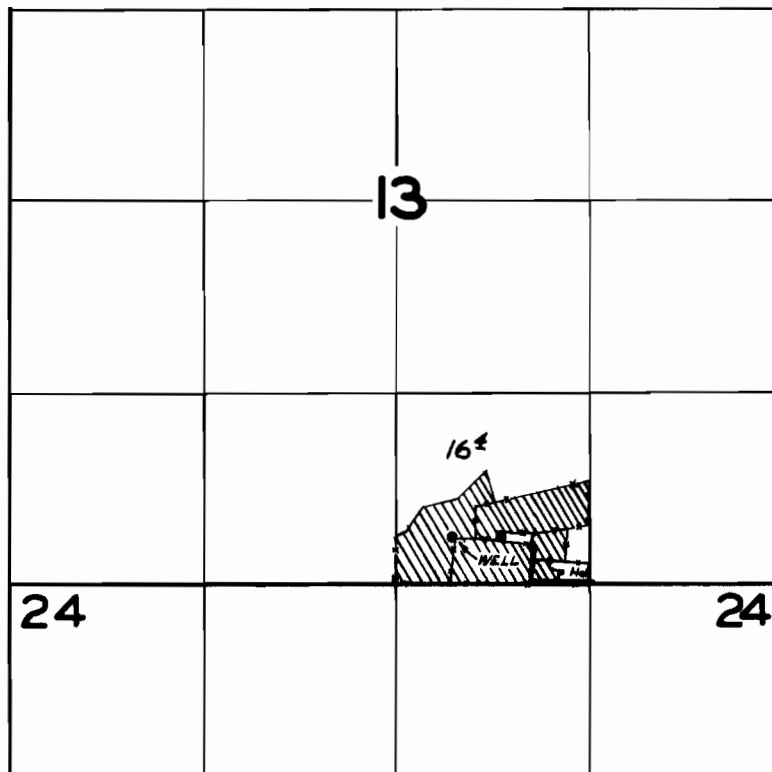

FINAL PROOF SURVEY
UNDER

Application No. G.966 Permit No. G.863
IN NAME OF

GLEN S. ROBY

Surveyed Mar. 22, 1961, by M. B. Lisk