


T.16S.R. 4W.W.M.

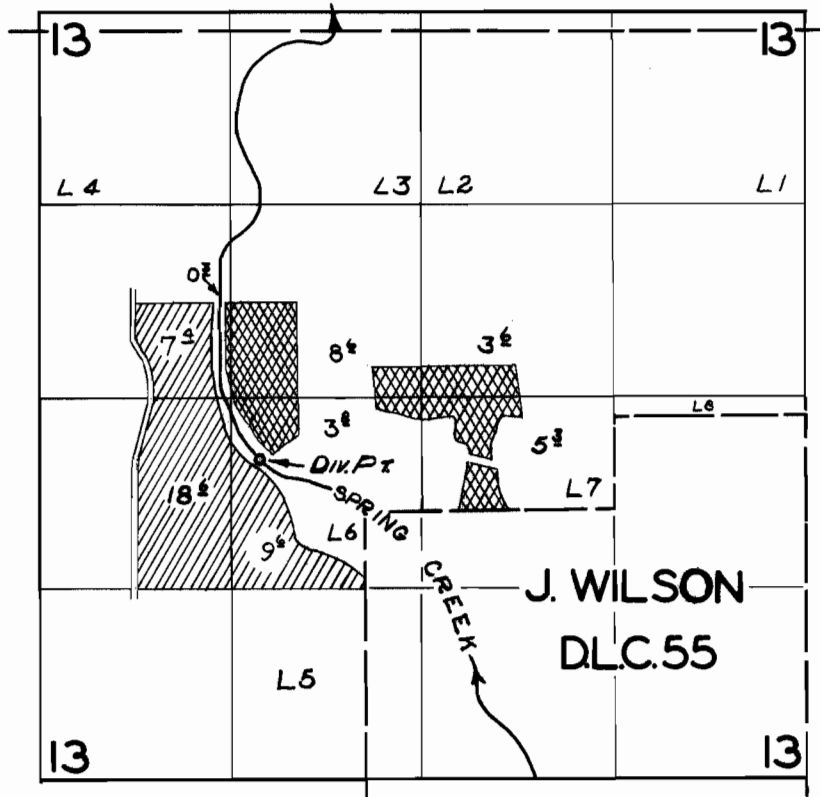

FINAL PROOF SURVEY UNDER



A. 31364

A.33251

Application No. 31364 33251..... Permit No. 24789 26288....

IN NAME OF

.....*JOHN S. HURD*.....

Surveyed *Mar 11* 1961., by *M. B. I. H.*.....