


T.16S.R.2W.W.M.

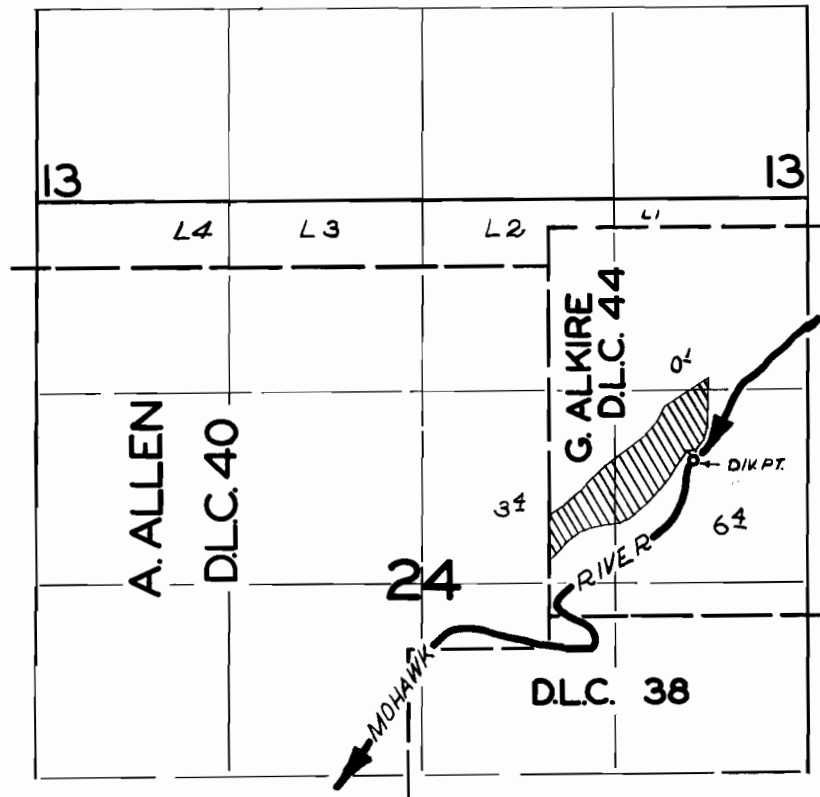

FINAL PROOF SURVEY  
UNDER

Application No. 31715..... Permit No. 25004.....  
IN NAME OF

..... GLENN F. & CAROL A. SPICER .....

Surveyed *Mar. 10* 1961, by *M. Bisk*.....