


T.18S.R.2W.W.M.

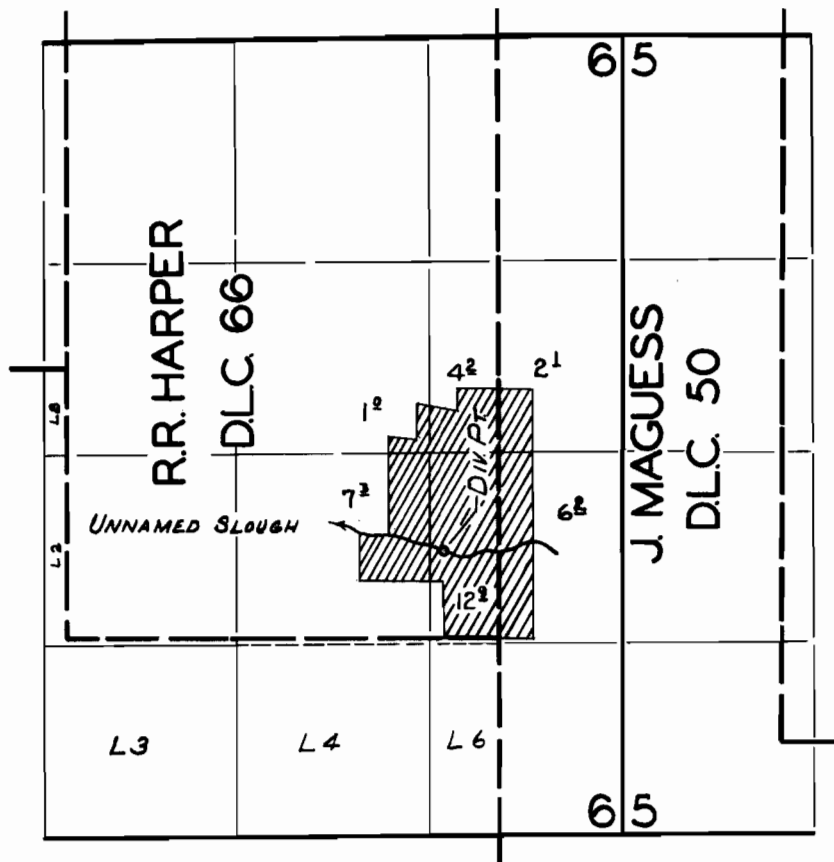

FINAL PROOF SURVEY
UNDER

Application No. 31924..... Permit No. 25172.....
IN NAME OF

.....*ERNEST M. & GRACE SKINNER*.....

Surveyed *JULY 20 1961*, by *C. O. BARTELS*.....