


T.20S.R.3W.W.M.

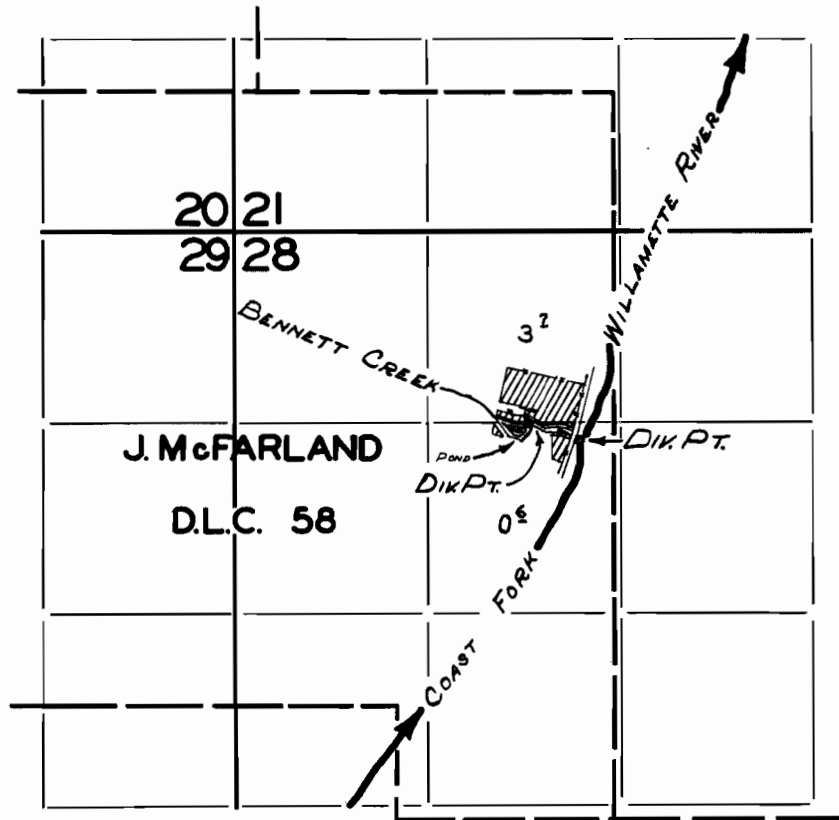

FINAL PROOF SURVEY
UNDER

Application No. 3194.6.... Permit No. 25185.....
IN NAME OF

.....LARRY H. & VELMA F. LEVENS.....

Surveyed *Mar. 24, 1961*, by *M. BISH*.....