



T.17S.R.3W.W.M.

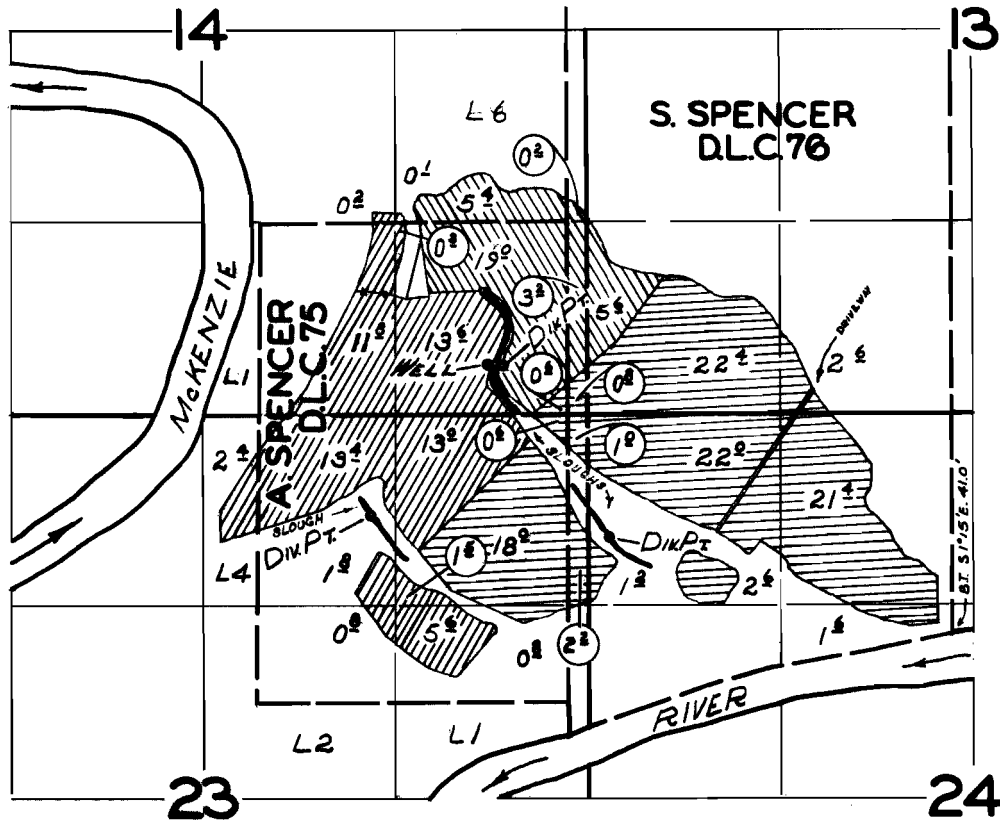

FINAL PROOF SURVEY

UNDER

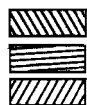

NORTH DIVERSION

EAST DIVERSION

WEST DIVERSION

Application No. 31941 Permit No. 25207

IN NAME OF

JOHN E. JAQUA

Surveyed MAY 8 1961, by M. BISH