


T.16 S.R.6 W.W.M.

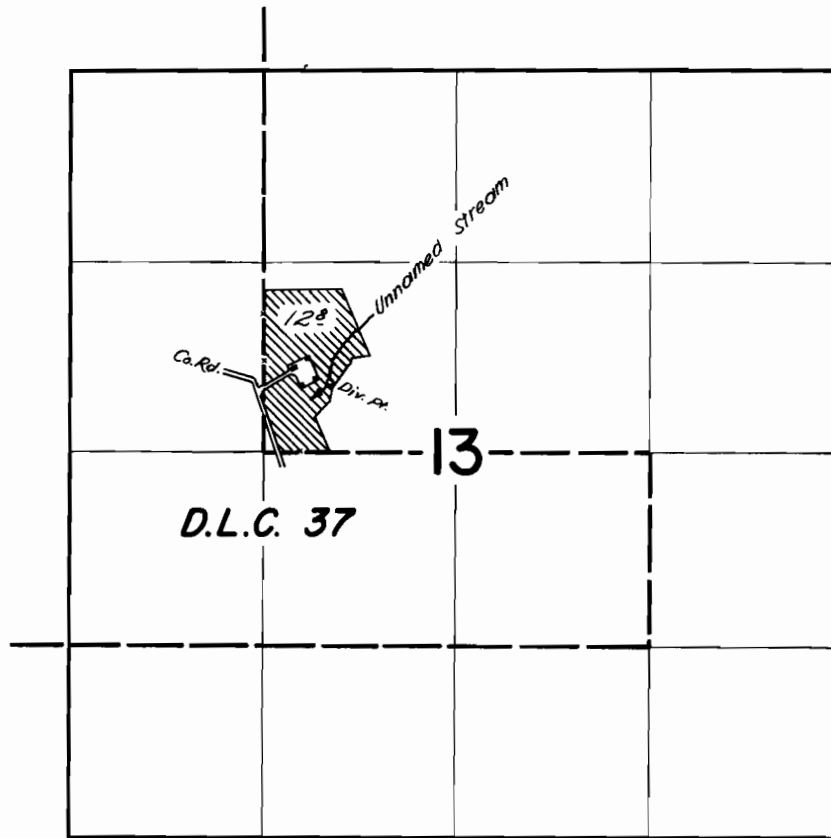

FINAL PROOF SURVEY
UNDER

Application No. **32546** Permit No. **25701**
IN NAME OF

Marvin Lester and/or Emma May Bentz

Surveyed *May 9* 1961, by *L. Jackson*