


T.16S.R.7W.W.M.

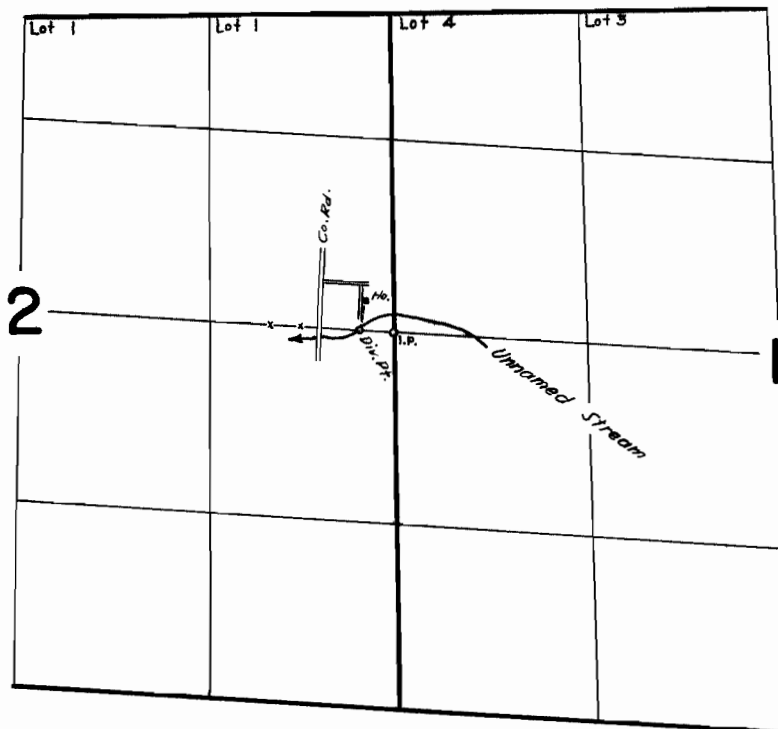

FINAL PROOF SURVEY
UNDER

Application No. **32989** Permit No. **26088**
IN NAME OF

PATRICK J. HAMPER

Surveyed *May 24* 1961, by *L. Jackson*