


T.17S.R.6W.W.M.

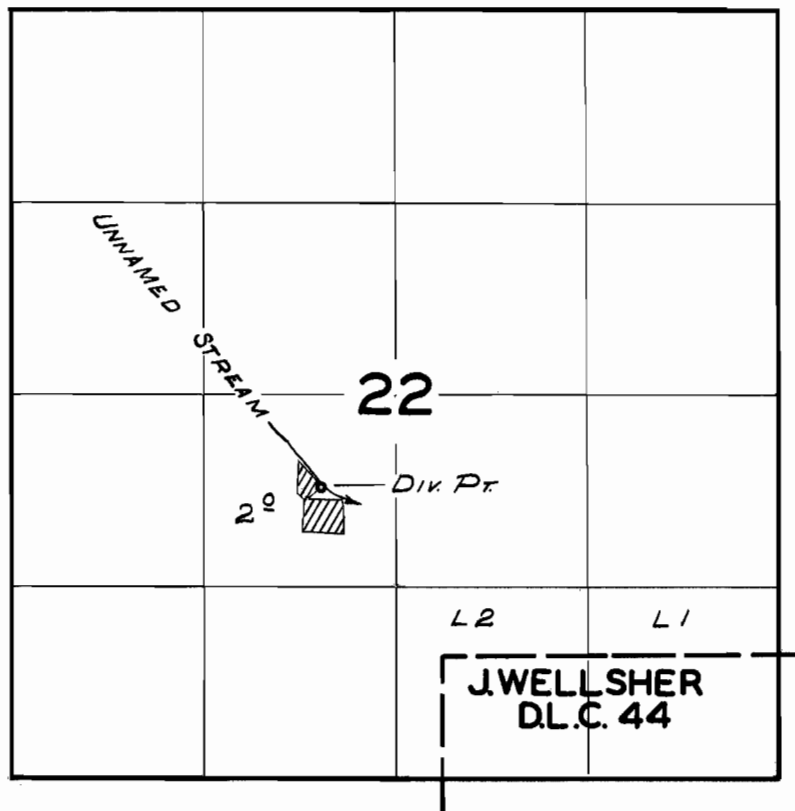

FINAL PROOF SURVEY
UNDER

Application No. 33055.. Permit No. 26144..
IN NAME OF

.....*HAROLD W. & HAZEL LIVINGSTON*.....

Surveyed *MAR 10* 1961, by *C.O. BARTELS*..