


T.16S.R.7 W.W.M.

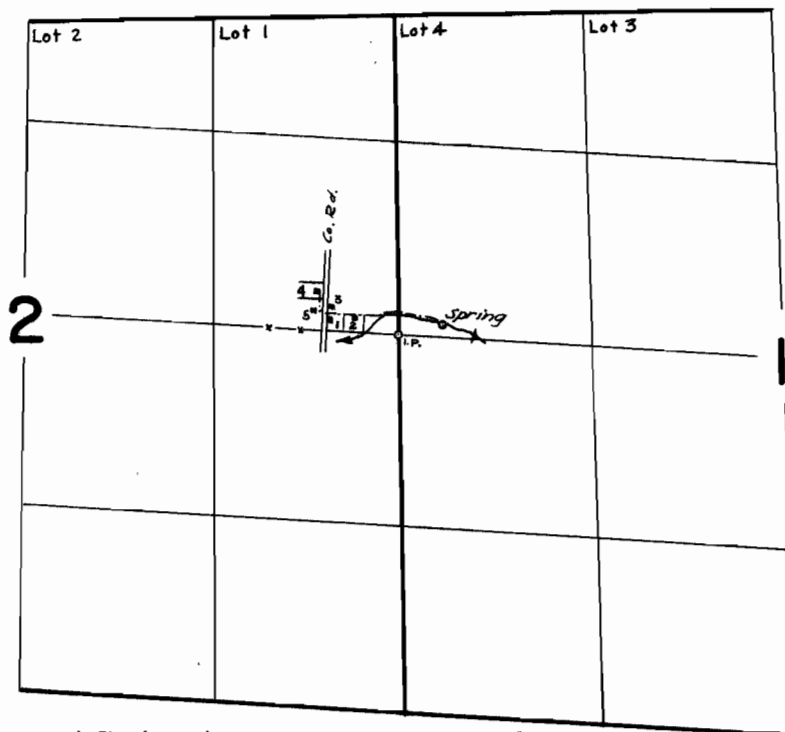

1. Clayton Jones
2. John Laferty
3. Harold James
4. Allord James
5. W. E. James

FINAL PROOF SURVEY
UNDER

Application No. 33075 Permit No. 26188

IN NAME OF

CLAYTON JONES, JOHN LAFERTY,
HAROLD, W.E., & ALLORD JAMES

Surveyed May 24 1961, by *R. H. Jackson*