


T.16S.R.2W.W.M.

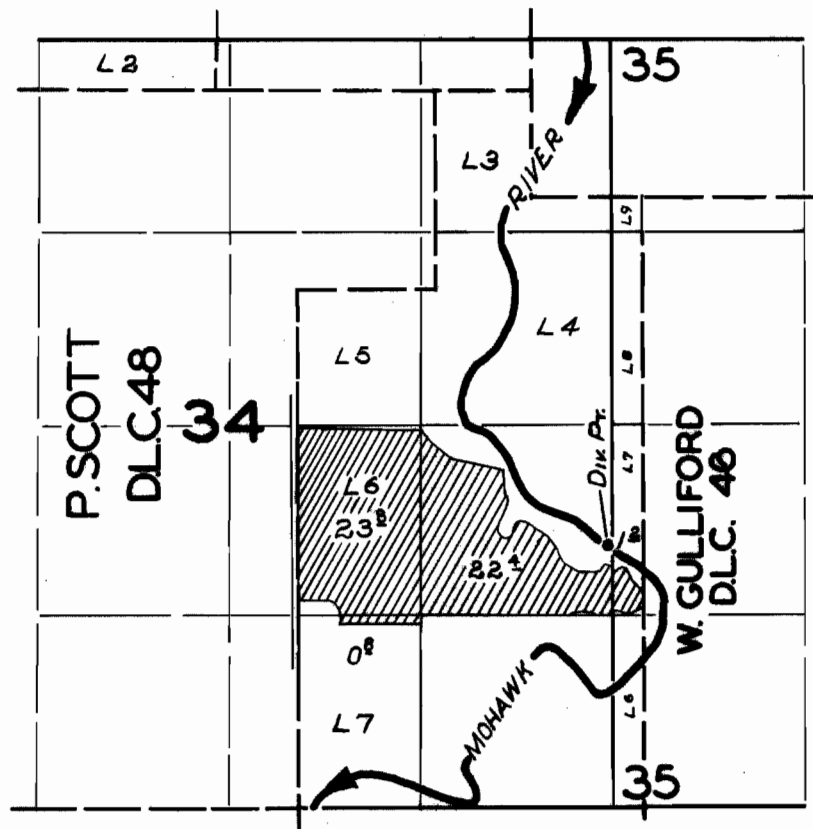

FINAL PROOF SURVEY
UNDER

Application No. 33123... Permit No. 26227...
IN NAME OF

.....*CHARLES FRANK JENSEN*.....

Surveyed *MAY 10*... 1961.., by *M. BISH*.....