


T.17S.R.1 E.W.M.

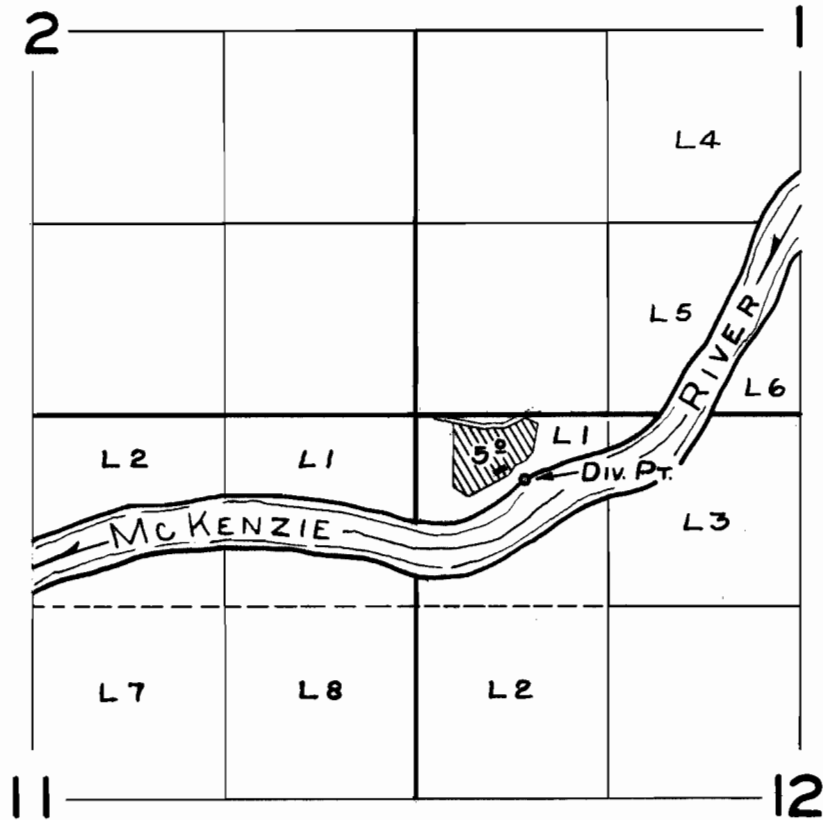

FINAL PROOF SURVEY
UNDER

Application No. 33352... Permit No. 26371...
IN NAME OF

.....ALVIN L. FLANDERS.....

Surveyed MAY 24 1961, by C. O. BARTELS..